


15-129-00092-0061

FORM CP-4

WELL PLUGGING RECORD

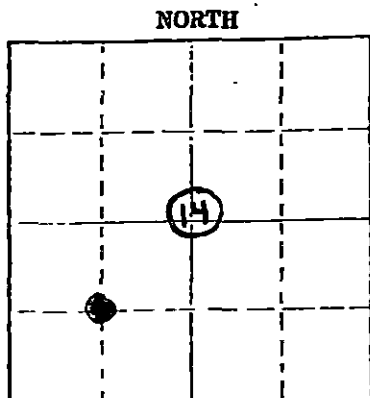

Morton County, Sec. 14 Twp. 31S Rge. (E) 43 (W)
Location as "NE/CNWSW" or footage from lines C NW/4 Sec. 14
Lease Owner Dyco Petroleum Corporation
Lease Name Hanke Well No. 1
Office Address 320 S. Boston, 420 NBT Bldg., Tulsa, OK 74103
Character of Well (completed as Oil, Gas or Dry Hole) Dry Hole
Date well completed 12/07/79 1979
Application for plugging filed 12/06/79 1979
Application for plugging approved Verbal: 12/06/79 1979
Plugging commenced 12/08/79 1979
Plugging completed 12/08/79 1979
Reason for abandonment of well or producing formation Non-productive of Hydrocarbons
If a producing well is abandoned, date of last production - 19 -
Was permission obtained from the Conservation Division or its agents before plugging was commenced? Yes

Name of Conservation Agent who supervised plugging of this well Mr. Tom Thompson
Producing formation Depth to top Bottom Total Depth of Well 5344' Feet
Show depth and thickness of all water, oil and gas formations.

OIL, GAS OR WATER RECORDS				CASING RECORD		
FORMATION	CONTENT	FROM	TO	SIZE	PUT IN	PULLED OUT
				8-5/8"	1471'	None

Describe in detail the manner in which the well was plugged, indicating where the mud fluid was placed and the method or methods used in introducing it into the hole. If cement or other plugs were used, state the character of same and depth placed, from feet to feet for each plug set.

Circulated hole w/9.0 ppg mud and set cement plugs as follows:
3200'-3000' 35 sks
2800'-2700' 25 sks
at 1460' 50 sks
at 800' 10 sks
5 sks cement in cellar

(If additional description is necessary, use BACK of this sheet)
Name of Plugging Contractor B-J Hughes
Address Perryton, Texas

STATE OF Oklahoma COUNTY OF Tulsa, ss.
Bob J. Zumwalt (employee of owner) or (owner or operator) of the above-described well, being first duly sworn on oath, says: That I have knowledge of the facts, statements, and matters herein contained and the log of the above-described well as filed and that the same are true and correct. So help me God.

(Signature) Bob Zumwalt

SUBSCRIBED AND SWORN to before me this 20th day of December, 1979

My commission expires Oct 2, 1983
Louis H. Kirkland Notary Public.

RECEIVED
STATE CORPORATION COMMISSION
DEC 26 1979
CONSERVATION DIVISION
Wichita, Kansas