


STATE OF KANSAS
 STATE CORPORATION COMMISSION
 Give All Information Completely
 Make Required Affidavit
 Mail or Deliver Report to:
 Conservation Division
 State Corporation Commission
 800 Biting Building
 Wichita, Kansas

15-129-60092-0000

WELL PLUGGING RECORD

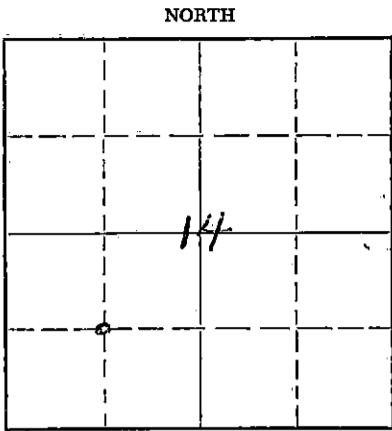

Locate well correctly on above Section Plat

Morton County. Sec. 14 Twp. 31 Rge. 43 (E) (W)
 Location as "NE/CNW/SW" or footage from lines. C-SW/4
 Lease Owner Colorado Oil & Gas Co.
 Lease Name Hanke Well No. 1-14
 Office Address Denver Club Bldg. - Denver, Colorado
 Character of Well (completed as Oil, Gas or Dry Hole) Dry Hole
 Date well completed 8-15 19 55
 Application for plugging filed 8-15 19 55
 Application for plugging approved 8-15 19 55
 Plugging commenced 8-15 19 55
 Plugging completed 8-15 19 55
 Reason for abandonment of well or producing formation Dry Hole

If a producing well is abandoned, date of last production _____ 19____
 Was permission obtained from the Conservation Division or its agents before plugging was commenced? yes

Name of Conservation Agent who supervised plugging of this well State Pluggers - Rives - Pratt, Kansas
 Producing formation _____ Depth to top _____ Bottom _____ Total Depth of Well 5350 Feet
 Show depth and thickness of all water, oil and gas formations.

OIL, GAS OR WATER RECORDS

CASING RECORD

FORMATION	CONTENT	FROM	TO	SIZE	PUT IN	PULLED OUT
		0'	1471'	9 5/8"	1471'	none

Describe in detail the manner in which the well was plugged, indicating where the mud fluid was placed and the method or methods used in introducing it into the hole. If cement or other plugs were used, state the character of same and depth placed, from _____ feet to _____ feet for each plug set.

From 5350' to 601 1/2' Heavy Rotary Mud.
 " 601 1/2' " 600' Wooden Plug.
 " 600' " 513' 35 sacks cement.
 " 513' " 41 1/2' Heavy Rotary Mud.
 " 41 1/2' " 40' Wooden Plug.
 " 40' " 2' 15 sacks cement.
 " 2' " surface to cellar.

STATE CORPORATION COMMISSION
 AUG 30 1955
 CONSERVATION DIVISION
 WICHITA, KANSAS

(If additional description is necessary, use BACK of this sheet)

Name of Plugging Contractor _____
 Address _____

STATE OF Kansas, COUNTY OF Barton, ss.
 _____ (employee of owner) or (owner or operator) of the above-described well, being first duly sworn on oath, says: That I have knowledge of the facts, statements, and matters herein contained and the log of the above-described well as filed and that the same are true and correct. So help me God.

(Signature) Marshall L. Reese
Box 88 - Hoisington, Kansas
 (Address)

SUBSCRIBED AND SWORN to before me this 19 day of August, 19 55
Marshall L. Reese
 Notary Public.

My commission expires September 28, 1957

24-7366-5 3-53-20M

PLUGGING
 WMA SEC. 14 TWP. 31 R. 43 W
 BOOK PAGE 143 LINE 12

DRILLERS LOG

15-129-00092-0000

Company: Colorado Oil & Gas Co.

SW/4

Sec: 14, Twn: 31, Rge: 43

Farm: Hanke Well No: 1-14

Total Depth: 5350'

County: Morton, Kansas

Comm: 7/13/55 Comp: 8/15/55

Contractor: Peel Brothers, Inc.

Elevation:

Casing:

9 5/8" @ 1471' Cem.

Production:

Figures below indicate bottom of formation

Shale and red bed	0'	300'
Shale and lime streaks		550
Shale, red bed and lime streaks		670
Anhydrite		710
Red bed		840
Red bed and Anhydrite streaks		1100
Sand		1106
Anhydrite and sand		1315
Sand		1507
Shale		1915
Red bed and brown lime		2120
Shale and Anhydrite streaks		2340
Shale		2640
Lime and shale		2827
Lime, shale and sand		2900
Lime		3005
Lime and shale		3140
Lime		3160
Lime and shale		3240
Lime		3305
Lime and shale		3465
Lime, shale and sand		3595
Lime and shale		3630
Lime, sandy shale		3725
Lime and shale		3845
Lime		3900
Lime, shale and sandy shale		4000
Lime streaks and shale		4060
Lime		4405
Lime, shale and sand streaks		4495
Lime, shale and sand		4545
Lime and shale		4720
Shale and lime streaks		4780
Shale, lime and sand streaks		4885
Shale		5065
Sand		5075
Shale and sand streaks		5130
Shale and sand		5142
Shale and lime		5150
Sand, shale and lime		5179
Lime		5185
Sand		5273
Lime		5350
Total Depth		5350

This is certify that the above is to the best of my knowledge true and correct.

PEEL BROTHERS, INC.

BY [Signature]

SUBSCRIBED AND SWORN TO before me this 19 day of August 1955

My commission expires September 28, 1957

[Signature]
Notary Public

PLUGGING
FELI SEC 14 T 31 R 43
BOOK PAGE 142 LINE 17