

15-095-00128-00-00

STATE OF KANSAS
STATE CORPORATION COMMISSION


Form CP-4

Give All Information Completely
Make Required Affidavit
Mail or Deliver Report to:
Conservation Division
State Corporation Commission
212 No. Market
Wichita, Kansas

WELL PLUGGING RECORD

Kingman County. Sec. 14 Twp. 30 Rge. 6W (W)
Location as "NE/CNW/SW" or footage from lines SE NE
Lease Owner Walter W. Clements, Jr.
Lease Name Smith Well No. 1
Office Address 501 First Nat'l Bk. Bldg., Wichita, Kansas
Character of Well (completed as Oil, Gas or Dry Hole) D&A
Date well completed _____ 19____
Application for plugging filed _____ 19____
Application for plugging approved _____ 19____
Plugging commenced _____ 19____
Plugging completed December 16, 19 60
Reason for abandonment of well or producing formation _____

NORTH

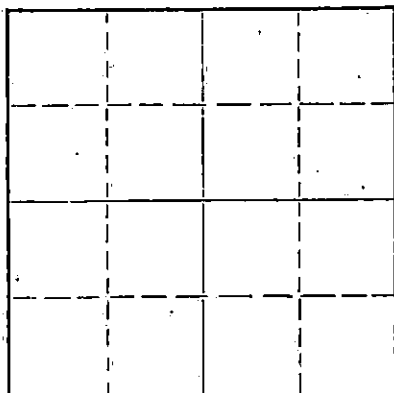

Locate well correctly on above
Section Plat

If a producing well is abandoned, date of last production _____ 19____
Was permission obtained from the Conservation Division or its agents before plugging was commenced? yes

Name of Conservation Agent who supervised plugging of this well Fred W. Hampel
Producing formation _____ Depth to top _____ Bottom _____ Total Depth of Well 4594' Feet
Show depth and thickness of all water, oil and gas formations.

OIL, GAS OR WATER RECORDS

CASING RECORD

FORMATION	CONTENT	FROM	TO	SIZE	PUT IN	PULLED OUT

Describe in detail the manner in which the well was plugged, indicating where the mud fluid was placed and the method or methods used in introducing it into the hole. If cement or other plugs were used, state the character of same and depth placed, from _____ feet to _____ feet for each plug set.

T. D. 4594' - S.P. 8 5/8" - 200' C W C
Heavy mud to 190', set plug used 1/4 sack hulls
15 sacks cement through drill pipe, mud to 40' set
plug-used 10 sacks cement to base of cellar.
Bridge rat hole-used 2 sacks cement.

(If additional description is necessary, use BACK of this sheet)

Name of Plugging Contractor Fortune Oil & Gas, Inc.
Address 909 Central Building Wichita, Kansas

STATE OF _____, COUNTY OF _____, ss.

(employee of owner) or (owner or operator) of the above-described well, being first duly sworn on oath, says: That I have knowledge of the facts, statements, and matters herein contained and the log of the above-described well as filed and that the same are true and correct. So help me God.

(Signature) X

(Address)

SUBSCRIBED AND SWORN TO before me this _____ day of _____, 19____

My commission expires _____

Notary Public.

15-095-00128-00-00


WELL LOG BUREAU--KANSAS GEOLOGICAL SOCIETY
508 East Murdock, Wichita, Kansas

Company- WALDEE W. CLIBBENS, JR.
Farm- Smith No. 1

SEC. 14 T. 30 R. 6W
SE NE

Total Depth. 4594'
Comm. 11-19-60 Comp. 12-10-60
Shot or Treated.
Contractor. Fortune Oil & Gas, Inc.
Issued. 8-24-63

County Kingman KANSAS

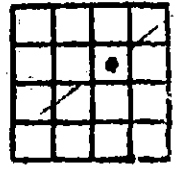

Elevation. 1401' RR

Production. Dry

Figures Indicate Bottom of Formations.

sand & shale	240
shale	890
shale & lime strks.	1120
lime	1660
shale & lime	3414
lime-Kansas City	3651
lime & shale	3843
lime	3921
lime & shale	4075
lime-Mississippi & Chat	4484
lime & shale	4504
shale	4515
lime & shale	4541
Sand Simpson	4594
Total Depth	

TOPS: ELEC LOG	
Kansas City	3526
Base Kansas City	3726
Marmaton	3842
Cherokee	3982
Mississippi	4106
Kinderhook	4426
Viola	4534
Simpson	4548
Simpson Sand	4570

RECEIVED
STATE CORPORATION COMMISSION
JUL 16 1964
CONSERVATION DIVISION
Wichita, Kansas