


STATE OF KANSAS
STATE CORPORATION COMMISSION

WELL PLUGGING RECORD

Give All Information Completely
Make Required Affidavit
Mail or Deliver Report to:
Conservation Division
State Corporation Commission
211 No. Broadway
Wichita, Kansas

Pratt County. Sec. 24 Twp. 28 Rge. 12 (#) (W)
Location as "NE/CNW/SW" or footage from lines SE SE NE
Lease Owner Isern Brothers
Lease Name Goyen Well No. 1
Office Address Box 45, Ellinwood, Kansas
Character of Well (completed as Oil, Gas or Dry Hole) Dry Hole
Date well completed August 18, 1956 19
Application for plugging filed August 18, 1956 19
Application for plugging approved August 18, 1956 19
Plugging commenced August 19, 1956 19
Plugging completed August 19, 1956 19
Reason for abandonment of well or producing formation Dry Hole

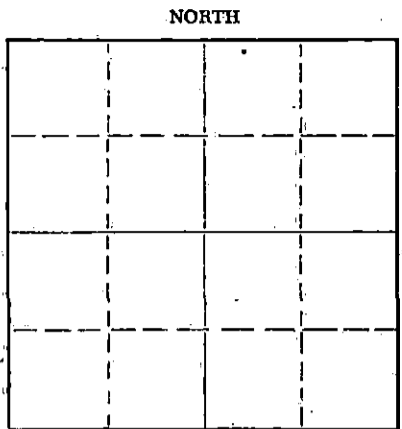

Locate well correctly on above Section Plat

If a producing well is abandoned, date of last production _____ 19____
Was permission obtained from the Conservation Division or its agents before plugging was commenced? yes

Name of Conservation Agent who supervised plugging of this well M. A. Rives
Producing formation _____ Depth to top _____ Bottom _____ Total Depth of Well 4570 Feet
Show depth and thickness of all water, oil and gas formations.

OIL, GAS OR WATER RECORDS

CASING RECORD

FORMATION	CONTENT	FROM	TO	SIZE	PUT IN	PULLED OUT
	Surface Pipe	0	331'	8-5/8"	331'	None

Describe in detail the manner in which the well was plugged, indicating where the mud fluid was placed and the method or methods used in introducing it into the hole. If cement or other plugs were used, state the character of same and depth placed, from _____ feet to _____ feet for each plug set.

Filled hole with heavy mud to 300'.
Bridged hole at 300'. Ran 35 sacks
cement 300' up. Bridge hole at 35',
ran 15 sacks cement. Plug 35' to
base of cellar.

RECEIVED
STATE CORPORATION COMMISSION
AUG 23 1956
CONSERVATION DIVISION
Wichita, Kansas
08-23-56

(If additional description is necessary, use BACK of this sheet)
Name of Plugging Contractor Isern Drilling Company
Address Box 45, Ellinwood, Kansas

STATE OF KANSAS COUNTY OF BARTON
I. M. M. Shropshire (employee of owner) or owner or operator of the above-described well, being first duly sworn on oath, says: That I have knowledge of the facts, statements, and matters herein contained and the log of the above-described well as filed and that the same are true and correct. So help me God.
(Signature) I. M. M. Shropshire
Lyons, Kansas (Address)

SUBSCRIBED AND SWORN TO before me this 20th day of August, 19 56
George A. Meyer
Notary Public.

My commission expires Feb. 10, 1959.

PLUGGING
FILE SEC. 24 T. 28 R. 12W
BOOK PAGE 91 LINE 24

WELL LOG

ISERN BROTHERS, OWNER - GOYEN #1
 SE/4 SE/4 NE/4 Section 24, Township 28, Range 12W,
 Pratt County, Kansas

ELEVATION: 1858 DF

Figures indicate bottom of formation
 0 to

45 shale
 125 sand
 260 shale
 331 Red Rock
 1015 Red Bed
 1210 shale & shells
 1380 salt
 1620 shale & shells
 2435 lime & shale
 2855 shale & shells
 3035 lime & shale
 3195 shale & shells
 3345 lime & shale
 3455 chalky lime
 3690 shale & lime
 3800 lime & shale
 4150 lime
 4180 lime, shale & chert
 4249 lime & chert
 4285 shale & lime
 4356 shale
 4412 lime & chert
 4483 lime & shale
 4487 lime, shale & chert
 4492 lime
 4509 shale
 4540 lime & shale
 4557 shale
 4570 lime
 4570 Rotary TD D&A

PIPE RECORD:

8-5/8" set at 331'
 Cemented with 250 sacks cement
 and 500# Calcium Chloride
 August 3, 1956

Well Commenced 8- 2-56
 Completed 8-19-56

STATE OF KANSAS)
 COUNTY OF BARTON) SS

I, M. M. Shropshire, Drilling Superintendent of the above-described well, being first duly sworn on oath, declare: That I have knowledge of the facts, statements and matters herein contained pertaining to the log of the above-described well, as filed, and that the same are true and correct.

STATE CORPORATION COMMISSION

AUG 23 1956

M. M. Shropshire

CONSERVATION DIVISION

Subscribed and Sworn to before me at this 20th day of August, 1956.

George A. Meyer
 Notary Public

My commission expires Feb. 10, 1959.

PLUGGING
 FILE SEC. 24 T. 28 R. 12W
 BOOK PAGE 91 LINE 24