


STATE OF KANSAS
STATE CORPORATION COMMISSION

Give All Information Completely
Make Required Affidavit
Mail or Deliver Report to:
Conservation Division
State Corporation Commission
212 No. Market
Wichita, Kansas

WELL PLUGGING RECORD

Pratt County, Sec. 23 Twp 28 Rge 12 (E) (W)
SW NW NE

Location as "NE/CNWxSWx" or footage from lines _____
Lease Owner Raymond Oil Co., Inc.
Lease Name Chitwood K#11 Well No. _____
Office Address Wichita, Kansas 67202
Character of Well (completed as Oil, Gas or Dry Hole) _____
Date well completed _____ 19____
Application for plugging filed _____ 19____
Application for plugging approved _____ 19____
Plugging commenced 11/10/69 _____ 19____
Plugging completed 11/15/69 _____ 19____
Reason for abandonment of well or producing formation depleted.

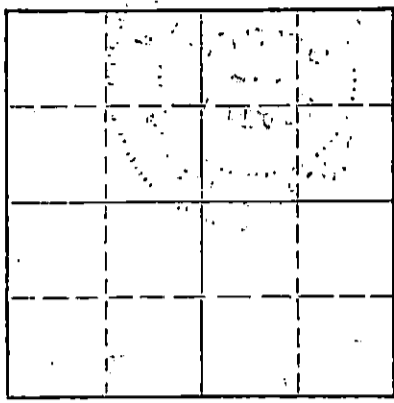

Locate well correctly on above Section Plat

If a producing well is abandoned, date of last production _____ 19____
Was permission obtained from the Conservation Division or its agents before plugging was commenced? yes

Name of Conservation Agent who supervised plugging of this well Justice
Producing formation _____ Depth to top _____ Bottom _____ Total Depth of Well 4454 Feet
Show depth and thickness of all water, oil and gas formations.

OIL, GAS OR WATER RECORDS

CASING RECORD

FORMATION	CONTENT	FROM	TO	SIZE	PUT IN	PULLED OUT
				10-3/4	313 NONE	none
				5 1/2	4500'	2118'

Describe in detail the manner in which the well was plugged, indicating where the mud fluid was placed and the method or methods used in introducing it into the hole. If cement or other plugs were used, state the character of same and depth placed, from _____ feet to _____ feet for each plug set.

Checked hole to 4454', ran sand to 4380' and dumped 5 sacks of cement.
Loaded hole, shot pipe at 3187', spotted 40 barrels of oil behind pipe.
Worked tension, pulled starting nipple out, Cleaned bealar and removed head.
Had collar welded on, rigged up and worked tension at no gain. Shot pipe at
3010', 2830', 2650', 2424', 2202', 2110', worked pipe loose and pulled 69
joints. Bailed fluid down to 260' and set 10' rock bridge. Dumped 35
sacks of cement. Mudded to 40', set 10' rock bridge and dumped 15 sacks
of cement.

PLUGGING COMPLETE.


RECEIVED
STATE CORPORATION COMMISSION
NOV 20 1969
CONSERVATION DIVISION
Wichita, Kansas

(If additional description is necessary, use BACK of this sheet)
Name of Plugging Contractor KNIGHT CASING PULLING CO., INC.
Address CHASE, KANSAS

STATE OF KANSAS COUNTY OF RICE, ss.
NOEL J. KNIGHT (employee of owner) or (owner or operator) of the above-described

well, being first duly sworn on oath, says: That I have knowledge of the facts, statements, and matters herein contained and the log of the above-described well as filed and that the same are true and correct. So help me God.

(Signature) Noel Knight
CHASE, KANSAS
(Address)

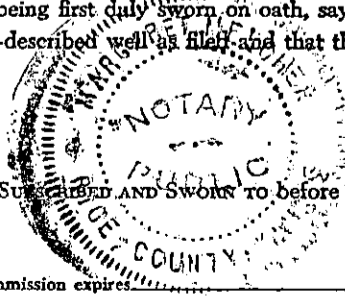

Subscribed and sworn to before me this 17th day of November, 19 69
Margaret Melcher
Notary Public.

My commission expires 2/15/71

