

STATE OF KANSAS
STATE CORPORATION COMMISSION


Form CP-4

Give All Information Completely
Make Required Affidavit
Mail or Deliver Report to:
Conservation Division
State Corporation Commission
212 No. Market
Wichita, Kansas

WELL PLUGGING RECORD

Pratt County, Sec. 23 Twp. 28 Rge. 12 (E) (W)

Location as "NE/CNW/SW" or footage from lines ~~NE SE SW~~ NE SE SW
Lease Owner Raymond Oil Co., Inc.
Lease Name Chitwood ~~xxxx~~ F-10 Well No. _____
Office Address Wichita, Kansas 67202
Character of Well (completed as Oil, Gas or Dry Hole) _____
Date well completed _____ 19____
Application for plugging filed _____ 19____
Application for plugging approved _____ 19____
Plugging commenced 10/7/69 _____ 19____
Plugging completed 10/14/69 _____ 19____
Reason for abandonment of well or producing formation depleted.
If a producing well is abandoned, date of last production _____ 19____
Was permission obtained from the Conservation Division or its agents before plugging was commenced? yes

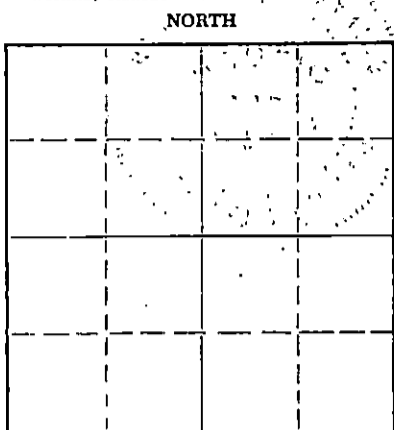

Locate well correctly on above Section Plat

Name of Conservation Agent who supervised plugging of this well Warren
Producing formation _____ Depth to top _____ Bottom _____ Total Depth of Well 4455 Feet
Show depth and thickness of all water, oil and gas formations.

OIL, GAS OR WATER RECORDS

CASING RECORD

FORMATION	CONTENT	FROM	TO	SIZE	PUT IN	PULLED OUT
				8-5/8	314'	none
				5 1/2"	4453'	3187'
						RECEIVED
						STATE CORPORATION COMMISSION
					10-22-69	OCT 22 1969
						CONSERVATION DIVISION
						Wichita, Kansas

Describe in detail the manner in which the well was plugged, indicating where the mud fluid was placed and the method or methods used in introducing it into the hole. If cement or other plugs were used, state the character of same and depth placed, from _____ feet to _____ feet for each plug set.

Checked hole to 4455' and ran sand to 4370', dumped 5 sacks of cement. Loaded hole, shot pipe at 3284', rigged pump up and broke pressure at 1100 lbs. Spotted 30 barrels of oil behind pipe, worked pipe at no gain. Shot pipe at 3198', rigged pump up and circulated pipe loose, pulled 102 joints of 5 1/2" casing. Bailed fluid down to 260' and set 10' rock bridge and dumped 25 sacks of cement. Mudded to 40', set 10' rock bridge and dumped 10 sacks of cement. Tallied pipe.

PLUGGING COMPLETE.

(If additional description is necessary, use BACK of this sheet)
KNIGHT CASING PULLING CO., INC.

Name of Plugging Contractor _____
Address CHASE, KANSAS

STATE OF KANSAS COUNTY OF RICE, ss.
NOEL J. KNIGHT (employee of owner) or (owner or operator) of the above-described well, being first duly sworn on oath, says: That I have knowledge of the facts, statements, and matters herein contained and the log of the above-described well, and that the same are true and correct. So help me God.

(Signature) Noel Knight
CHASE, KANSAS

(Address)

Subscribed and sworn to before me this 15th day of October, 1969

My commission expires 12/15/71

Margaret Mulchee
Notary Public.

UNIT WELL F-10
(Chitwood Well No. 6)

NE Corner SE/4 SW/4
Sec. 23-28S-12W
Pratt County, Kansas

Contractor: The R. W. Rine Drilling Co.

Started: November 3, 1943

Finished: December 13, 1943

	LOG	
Sand and clay	Top- 40	
Sand	40-235	
Red bed & shells	235- 355	8-5/8" casing cemented at 319'
Shale & red bed	355- 700	
Shale & shells	700-1035	
Salt, shale & shells	1035-1305	
Salt & shells	1305-1685	
Lime & shale	1685-2145	
Shale & lime shells	2145-2245	
Shale & shells	2245-2330	
Shale & sandy lime	2330-2435	
Shale & shells	2435-2710	
Shale & lime	2710-2830	
Shale & shells	2830-2905	
Shale & lime	2905-2990	
Shale & shells	2990-3135	
Lime	3135-3270	
Shale & shells	3270-3390	
Lime (broken)	3390-3463	
Lime & shale	3463-3807	
Lime	3807-3920	
Lime & shale	3920-3978	
Lime	3978-4070	
Lime &	4070-4124	
Lime	4124-4214	
Shale, Lime Shells	4214-4263	
Lime & shale	4263-4320	
Lime (cherty)	4320-4385	
Shale	4385-4390	
Sand	4390-4460	
Shale	4460-4505	
Lime	4505-4507	
Shale & lime	4507-4510	5 1/2" casing cemented at 4510' Total Depth 4510'

RECEIVED
STATE CORPORATION COMMISSION
SEP 17 1969
CONSERVATION DIVISION
Wichita, Kansas

STATE OF KANSAS)
COUNTY OF PRATT) ss.

I, Vernon Hayes, do hereby certify that the above log is true and accurate to the best of my knowledge and belief.

Vernon Hayes

Subscribed and sworn to before me this 23rd day of June, 1954.

Don Deibel
Notary Public

My Commission Expires August 29, 1955.