


STATE OF KANSAS  
STATE CORPORATION COMMISSION

Form CP-4

Give All Information Completely  
Make Required Affidavit  
Mail or Deliver Report to:  
Conservation Division  
State Corporation Commission  
P. O. Box 17027  
Wichita, Kansas 67217  
NORTH

WELL PLUGGING RECORD

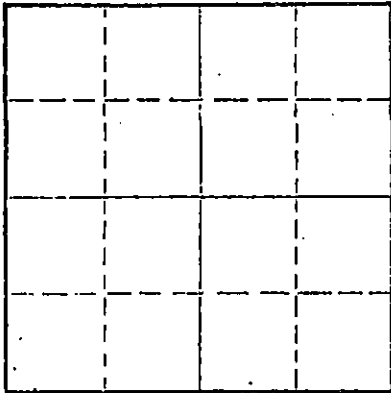

Locate well correctly on above  
Section Plat

Pratt County, Sec. 23 Twp. 28S Rge. 12 (E) (W)  
Location as "NE/CNW&SW" or footage from lines SWc SW NW  
Lease Owner Raymond Oil Co., Inc.  
Lease Name Chitwood I-7 Well No.  
Office Address Wichita, Kansas 67202  
Character of Well (completed as Oil, Gas or Dry Hole)  
Date well completed 19  
Application for plugging filed 19  
Application for plugging approved 19  
Plugging commenced 1/30/73 19  
Plugging completed 2/7/73 19  
Reason for abandonment of well or producing formation depleted.

If a producing well is abandoned, date of last production 19  
Was permission obtained from the Conservation Division or its agents before plugging was commenced? yes

Name of Conservation Agent who supervised plugging of this well Biberstein  
Producing formation Depth to top Bottom Total Depth of Well 4460 Feet  
Show depth and thickness of all water, oil and gas formations.

OIL, GAS OR WATER RECORDS

CASING RECORD

FORMATION	CONTENT	FROM	TO	SIZE	PUT IN	PULLED OUT
				9"	318	none
				5 1/2"	1159	2061

Describe in detail the manner in which the well was plugged, indicating where the mud fluid was placed and the method or methods used in introducing it into the hole. If cement or other plugs were used, state the character of same and depth placed, from feet to feet for each plug set.

Checked hole, sanded hole to 4420' and ran 5 sacks of cement.  
Shot pipe at 2920', spotted 40 barrels oil. Shot pipe at 2824',  
2630', 2442', 2347', 2250', 2156', 2060', pulled 65 joints. Set  
rock bridge at 2150' and plugged well with 4 yards ready mix.

PLUGGING COMPLETE.

K

RECEIVED  
STATE CORPORATION COMMISSION

FEB 26 1973

CONSERVATION DIVISION  
Wichita, Kansas

(If additional description is necessary, use BACK of this sheet)  
Name of Plugging Contractor VOTH CASING PULLING  
Address CHASE, KANSAS

STATE OF KANSAS, COUNTY OF RICE, ss.  
WALTER VOTH (employee of owner) or (owner or operator) of the above-described  
well, being first duly sworn on oath, says: That I have knowledge of the facts, statements, and matters herein contained and the log of the  
above-described well as filed and that the same are true and correct. So help me God.

(Signature) Walter Voth  
CHASE, KANSAS (Address)

SUBSCRIBED AND SWORN TO before me this 19th day of February, 1973.

My commission expires  
MARGARET MELCHER  
NOTARY PUBLIC  
Rice County, Kansas  
My Commission Expires  
Feb. 15, 1975

Margaret Melcher  
Notary Public.

Chitwood #8  
W/2-NW/4-NW/4 Section 23-28S-12W  
Pratt County, Kansas  
Lion Oil Company

SW<sub>e</sub> SW NW

Commenced: September 19, 1945  
 Completed: October 30, 1945

Sand and gravel	0	250	: Lime	4380	4386
Red bed	250	630	Lime, sand and shale	4386	4424
Lime	630	655	Sand	4424	4438
Red bed, shale and shells	655	680	Sand, hard	4438	4450
Shale, shells	680	870	Sand and shale	4450	4458
Red bed and shale	870	891	Shale and lime	4458	4460
Shale and shells	891	1155			
Lime, shale	1155	1300	TOTAL DEPTH	4460	
Shale and shells	1300	1455			
Shale, shells and salt	1455	1650			
Salt	1650	1675			
Anhydrite	1675	1890			
Lime	1890	1925			
Lime, broken	1925	2050			
Lime	2050	2150			
Lime, broken	2150	2230			
Lime	2230	2360			
Lime, broken	2360	2440			
Shale and lime	2440	2847			
Lime	2847	2990			
Lime, shale, lime	2990	3090			
Lime	3090	3225			
Sand	3225	3235			
Shale, lime	3235	3385			
Lime	3385	3620			
Shale and lime	3620	3695			
Lime	3695	3700			
Shale and lime	3700	3750			
Shale and lime, junk	3750	3768			
Shale, lime	3768	3779			
Lime and junk	3779	3802			
Lime	3802	3832			
Lime, junk	3832	3873			
Lime	3873	3895			
Lime, broken	3895	3970			
Lime	3970	3992			
Shale and lime	3992	4048			
Cherty lime, shale	4048	4062			
Lime	4062	4150			
Chert and lime	4150	4233			
Lime	4233	4267			
Shale and lime	4267	4310			
Lime, broken	4310	4327			
Cherty lime	4327	4380			

CASING RECORD

9" casing set at 318' and cemented with 200 sacks cement.  
 5½" casing set at 4459' and cemented with 250 sacks cement.

RECEIVED  
 STATE CORPORATION COMMISSION  
 JAN 30 1973  
 CONSERVATION DIVISION  
 Wichita, Kansas

STATE OF OKLAHOMA )  
 COUNTY OF TULSA )

I hereby affirm that the above and foregoing is a true and correct copy of the log of your Chitwood #8 Well, located in the West Half of the Northwest Quarter of the Northwest Quarter of Section 23, Township 28 South, Range 12 West, Pratt County, Kansas.

HELMERICH & PAYNE, INC.

By William Good  
 Treasurer

Subscribed and sworn to before me, a Notary Public, this 13th day of November, 1945.

W. Griffin  
 Notary Public

My commission expires July 22, 1947.