


STATE OF KANSAS
STATE CORPORATION COMMISSION

Give All Information Completely
Make Required Affidavit
Mail or Deliver Report to:
Conservation Division
State Corporation Commission
800 Bittling Building
Wichita, Kansas

WELL PLUGGING RECORD

NORTH

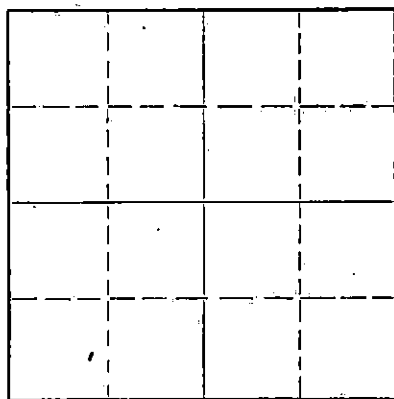

Locate well correctly on above
Section Plat

Morton County, Sec. 16 Twp. 33 Rge. 13 XXX (W)
Location as "NE/CNW/SW" or footage from lines 1250' fr N-L & 1250' fr W-Line
Lease Owner Cities Service Oil Co.
Lease Name Addington Well No. B#1
Office Address Bartlesville, Oklahoma
Character of Well (completed as Oil, Gas or Dry Hole) Dry Hole
Date well completed 4-21-56 Dry Hole 19
Application for plugging filed 4-30-56 19
Application for plugging approved 5-1-56 19
Plugging commenced 6-23-56 19
Plugging completed 7-10-56 19
Reason for abandonment of well or producing formation Dry - swabbing 135 gal.
salt water/hour with show gas
If a producing well is abandoned, date of last production 19
Was permission obtained from the Conservation Division or its agents before plugging was commenced? Yes

Name of Conservation Agent who supervised plugging of this well R. J. Phillippe
Producing formation Depth to top Bottom Total Depth of Well 5140 Feet
Show depth and thickness of all water, oil and gas formations.

OIL, GAS OR WATER RECORDS

CASING RECORD

FORMATION	CONTENT	FROM	TO	SIZE	PUT IN	PULLED OUT
Topeka	Salt water	3050	2938	8-5/8"	1383	None
				5 1/2"	3100	1061

Describe in detail the manner in which the well was plugged, indicating where the mud fluid was placed and the method or methods used in introducing it into the hole. If cement or other plugs were used, state the character of same and depth placed, from feet to feet for each plug set.

Mixed 100 sacks cement, pumped plug to 2550'; squeezed to 800#; reclaimed 1061' of 5 1/2" casing; filled hole with heavy rotary mud to 20' of ground level; cement to 4' of surface at which point the surface pipe was cut off and a steel cap welded on the 8-5/8" casing.

RECEIVED
STATE CORPORATION COMMISSION
JUL 21 1956
CONSERVATION DIVISION
Wichita, Kansas

(If additional description is necessary, use BACK of this sheet)

Name of Plugging Contractor Daco Lease & Well Servicing Co.
Address 1700 So. Main St., Borger, Texas

STATE OF KANSAS, COUNTY OF SEWARD, ss.
H. V. Anderson (employee of owner) or (owner or operator) of the above-described well, being first duly sworn on oath, says: That I have knowledge of the facts, statements, and matters herein contained and the log of the above-described well as filed and that the same are true and correct. So help me God.

(Signature) H. V. Anderson

Box 70, Liberal, Kansas
(Address)

SUBSCRIBED AND SWORN to before me this 19th day of July, 1956

My commission expires 5-23-1957

J. T. Mabrey
Notary Public.

24-2675-S 2-52-20M

