


Give All Information Completely
Make Required Affidavit
Mail or Deliver Report to:
Conservation Division
State Corporation Commission
212 No. Market
Wichita, Kansas

WELL PLUGGING RECORD

NORTH

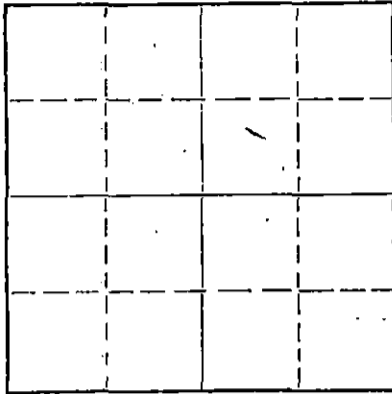

Locate well correctly on above
Section Plat

Kingman County, Sec. 26 Twp. 29S Rge. 8 (W)
Location as "NE/CNW/SW" or footage from lines NW NW
Lease Owner Texaco Inc.
Lease Name M. E. Plush Well No. 1
Office Address 614 Bitting Bldg., Wichita, Kansas 67202
Character of Well (completed as Oil, Gas or Dry Hole) Dry Hole
Date well completed 12-9-1966
Application for plugging filed 12-6-1966
Application for plugging approved 12-7-1966
Plugging commenced 12-8-1966
Plugging completed 12-9-1966
Reason for abandonment of well or producing formation Dry Hole

If a producing well is abandoned, date of last production None 19
Was permission obtained from the Conservation Division or its agents before plugging was commenced? Yes

Name of Conservation Agent who supervised plugging of this well A. Elving
Producing formation Dry Hole Depth to top Bottom Total Depth of Well Feet
Show depth and thickness of all water, oil and gas formations.

OIL, GAS OR WATER RECORDS

CASING RECORD

FORMATION	CONTENT	FROM	TO	SIZE	PUT IN	PULLED OUT
				8-5/8"	256'	None
				4-1/2"	2760'	2244'

Describe in detail the manner in which the well was plugged, indicating where the mud fluid was placed and the method or methods used in introducing it into the hole. If cement or other plugs were used, state the character of same and depth placed, from feet to feet for each plug set.

Rec 2244' 4 1/2" csg. Hole plugged as follows: 2649-255 w/mud, wooden plug at 255'. 255-245 w/rock, 245-170 w/25 sxs cmt, 170-40 w/mud, 40-30 w/rock, 30-0 w/10 sxs cmt.

RECEIVED
STATE CORPORATION COMMISSION

DEC 28 1966

CONSERVATION DIVISION
WICHITA, KANSAS

(If additional description is necessary, use BACK of this sheet)

Name of Plugging Contractor Sterling Drilling Company
Address Box 129, Sterling, Kansas

STATE OF KANSAS, COUNTY OF SEDGWICK, ss.
F. E. Anderson (employee of owner) or (owner/producer) of the above-described well, being first duly sworn on oath, says: That I have knowledge of the facts, statements, and matters herein contained and the log of the above-described well as filed and that the same are true and correct. So help me God.

(Signature) F. E. Anderson
614 Bitting Bldg., Wichita, Kansas (Address)

SUBSCRIBED AND SWORN TO before me this 22nd day of December, 1966

Dorothy Sue Jones
Notary Public.

My commission expires 10-13-69

STERLING DRILLING COMPANY
Sterling, Kansas

WELL LOG ----- M. E. PLUSH #1

LOCATED: NW 1/4 Section 26-25S-5W, Kingman County, Kansas

OWNER: Texaco, Inc.

ROTARY DRILLING CONTRACTOR: Sterling Drilling Company

COMMENCED: November 14, 1966

COMPLETED: November 30, 1966

ROTARY TOTAL DEPTH: 1597'

LOG	
0 - 40	Clay
40 - 480	Red Bed
480 - 1200	Shale
1200 - 1200	Lime & Shale
1200 - 1335	Lime & Chert
1335 - 1389	Lime & Chert
1389 - 1434	Lime
1434 - 1475	Lime & Shale
1475 - 1575	Lime
1575 - 1597	Lime & Shale T.D.

CASING RECORD

Run 7 joints (244.35') 8-5/8" 20' new
double end casing, pipe set at 256.35'
K.O., 200 sacks Pozmix #1, 2% C.C.
Plug was down at 9:00 p.m. by Henco.

RECEIVED
STATE CORPORATION COMMISSION

DEC 7 1966

CONSERVATION DIVISION
Wichita, Kansas

Run 85 joints 4-1/2" 10-1/2" new
casing, pipe set at 271.0'
K.O., cemented with 125 sacks Pozmix
#1. Plug was down at 6:00 a.m. by
Halliburton.