


STATE OF KANSAS
STATE CORPORATION COMMISSION

WELL PLUGGING RECORD

Give All Information Completely
Make Required Affidavit
Mail or Deliver Report to:
Conservation Division
State Corporation Commission
211 No. Broadway
Wichita, Kansas

Kingman County. Sec. 26 Twp. 29 Rge. 8 (E) 8 (W)
Location as "NE/CNW/SW" or footage from lines SW SW SW
Lease Owner Petroleum, Inc.
Lease Name DUICKWORTH Well No. 1
Office Address 311 East Third, Wichita, Ks.
Character of Well (completed as Oil, Gas or Dry Hole) Dry Hole
Date well completed June 28 19 56
Application for plugging filed June 28 19 56
Application for plugging approved June 28 19 56
Plugging commenced June 28 19 56
Plugging completed June 28 19 56
Reason for abandonment of well or producing formation Dry Hole

NORTH

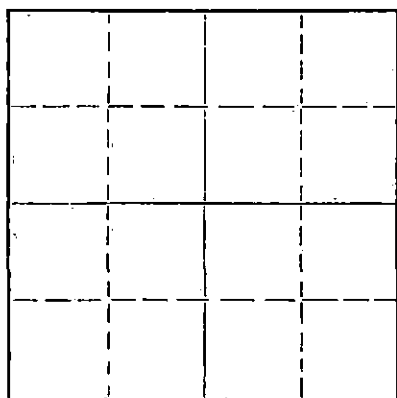

Locate well correctly on above
Section Plat

Name of Conservation Agent who supervised plugging of this well Mr. M. A. Rives, Pratt, Ks.
Producing formation _____ Depth to top _____ Bottom _____ Total Depth of Well 4302 Feet
Show depth and thickness of all water, oil and gas formations.

OIL, GAS OR WATER RECORDS

CASING RECORD

FORMATION	CONTENT	FROM	TO	SIZE	PUT IN	PULLED OUT
				8-5/8"	280'	None

Describe in detail the manner in which the well was plugged, indicating where the mud fluid was placed and the method or methods used in introducing it into the hole. If cement or other plugs were used, state the character of same and depth placed, from _____ feet to _____ feet for each plug set.

Mud up with heavy mud to 275, followed by wooden plug. Placed 20 sacks cement through drill pipe onto plug. Mud up to 35' and placed 1/4 sack hulls at 35' followed by wooden plug and 10 sacks cement to base of well cellar.

RECEIVED
STATE CORPORATION COMMISSION
JUL 24 1956
CONSERVATION DIVISION
KANSAS

(If additional description is necessary, use BACK of this sheet)

Name of Plugging Contractor Garvey Drilling Company
Address R. R. #2 - Great Bend, Kansas

STATE OF KANSAS COUNTY OF SEDGWICK, ss.
CULLEN THOMAS (employee of owner) or (owner or operator) of the above-described well, being first duly sworn on oath, says: That I have knowledge of the facts, statements, and matters herein contained and the log of the above-described well as filed and that the same are true and correct. So help me God.

(Signature) Cullen Thomas
311 East Third, Wichita, Kansas
(Address)

SUBSCRIBED AND SWORN TO before me this 29th day of June, 19 56

My commission expires September 2, 1959

Frances Sloan
Notary Public.

FRANCES SLOAN, Notary Public
My Commission expires Sept. 2, 1959

PLUGGING
FILE SEC. 26 T. 29 R. SW
BOOK PAGE 76 LINE 12

WELL LOG

COMPANY Petroleum, Inc.

SEC. 26 T. 29S R. 8W

FARM DUCKWORTH

NO. 1

LOC. SW SW SW


TOTAL DEPTH 4302'

COUNTY Kingman

COMM. June 16, 1956

COMP. June 28, 1956

CONTRACTOR Garvey Drilling Company

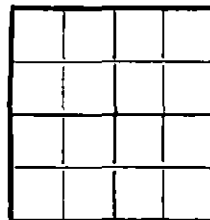

CASING 8-5/8" @ 280' w/250 sax

ELEVATION 1610' DF
1612' RB

PRODUCTION D & A

FIGURES INDICATE BOTTOM OF FORMATIONS

280	Surface
1080	Shale
1210	Shale & Shells
1290	Salt
1710	Shale & Shells
2330	Lime
3490	Shale & Lime
3955	Lime
4062	Lime & Shale
4095	Lime
4230	Lime & Shale
4260	Chert
4302	Lime

Sample Tops

Heebner	3232	(- 1620)
Toronto	3253	(- 1641)
Douglas	3280	(- 1668)
Lansing	3461	(- 1849)
Mississippi	4207	(- 2595)

RTD 4302'

RECEIVED
STATE

COMMISSIONER

State of KANSAS }
 County of SEDGWICK } SS:

PLUGGING
 FILE SEC 26 T. 29 R. 8W
 BOOK PAGE 76 LINE 12

I, Cullen Thomas of Petroleum, Inc.

upon oath state that the above and foregoing is a true and correct copy of the log of the DUCKWORTH #1 well

Subscribed and sworn to before me this 5th day of July 19 56

My Commission Expires: September 2, 1959

NOTARY PUBLIC

FRANCES SLOAN, Notary Public
My Commission expires Sept. 2, 1959