


STATE OF KANSAS
STATE CORPORATION COMMISSION

Form CP-4

Give All Information Completely
Make Required Affidavit
Mail or Deliver Report to:
Conservation Division
State Corporation Commission
212 No. Market
Wichita, Kansas

WELL PLUGGING RECORD

Kingman County. Sec. 24 Twp. 29S Rge. (E) 8 (W)
Location as "NE/CNWxSWx" or footage from lines C-SW-NE
Lease Owner Zenith Drilling Corporation, Inc.
Lease Name Calkin Well No. 1
Office Address 300 West Douglas, Wichita, Kansas 67202
Character of Well (completed as Oil, Gas or Dry Hole) Gas
Date well completed January 16, 19 71
Application for plugging filed April 19, 19 71
Application for plugging approved April 20, 19 71
Plugging commenced 4-21 19 71
Plugging completed 10 P.M. 4-26 19 71
Reason for abandonment of well or producing formation Non-productive

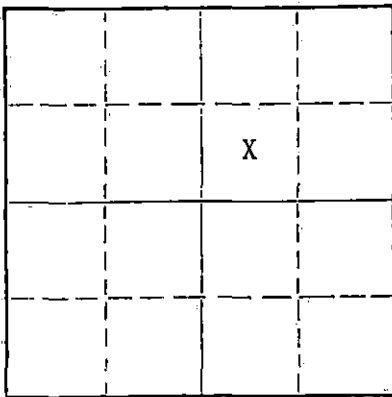

Locate well correctly on above Section Plat

If a producing well is abandoned, date of last production 19
Was permission obtained from the Conservation Division or its agents before plugging was commenced? Yes

Name of Conservation Agent who supervised plugging of this well Russell Biberstien
Producing formation _____ Depth to top _____ Bottom _____ Total Depth of Well 4565' Feet
Show depth and thickness of all water, oil and gas formations.

OIL, GAS OR WATER RECORDS

CASING RECORD

FORMATION	CONTENT	FROM	TO	SIZE	PUT IN	PULLED OUT
				8 5/8	250	None
				4 1/2	4564	

Describe in detail the manner in which the well was plugged, indicating where the mud fluid was placed and the method or methods used in introducing it into the hole. If cement or other plugs were used, state the character of same and depth placed, from _____ feet to _____ feet for each plug set.

Pump 10 sacks cement in to perf. Left 100 foot in pipe. Ripped 4 1/2 at 3700'. Ripped at 3600, 3500 and 3400.

Built rock bridge at 245' Then dumped 4 yards of Ready Mix Cement and plugged hole to top.

RECEIVED
STATE CORPORATION COMMISSION
MAY 12 1971
CONSERVATION DIVISION
Wichita, Kansas

(If additional description is necessary, use BACK of this sheet)
Name of Plugging Contractor Clarke Corporation
Address 107 West Fowler, Medicine Lodge, Kansas 67104

STATE OF KANSAS, COUNTY OF SEDGWICK, ss.
C. Robert Buford (owner or operator) of the above-described

well, being first duly sworn on oath, says: That I have knowledge of the facts, statements, and matters herein contained and the log of the above-described well as filed and that the same are true and correct. So help me God.

(Signature) C. Robert Buford
Suite 600 - 200 W. Douglas, Wichita, Kansas
(Address) 67202

SUBSCRIBED AND SWORN to before me this 6th day of May, 19 71.

My commission expires August 15, 1971.

Myrna D. Murphy
Notary Public.

