

STATE OF KANSAS  
STATE CORPORATION COMMISSION


WELL PLUGGING RECORD

Give All Information Completely  
Make Required Affidavit  
Mail or Deliver Report to:  
Conservation Division  
State Corporation Commission  
211 No. Broadway  
Wichita, Kansas

Kingman County, Sec. 24 Twp. 29 S Rge. 8 (E) (W)

Location as "NE/CNW/SW" or footage from lines S $\frac{1}{2}$  N $\frac{1}{2}$  SE $\frac{1}{4}$  24-29-8W  
Lease Owner Vincent Oil Corporation  
Lease Name Calkin Well No. #1  
Office Address 901 Union Center, Wichita, Kansas  
Character of Well (completed as Oil, Gas or Dry Hole) Dry Hole  
Date well completed March 7, 1973  
Application for plugging filed August 1, 1974  
Application for plugging approved 8-5-74 & Renewal 5-9-75  
Plugging commenced 5-9-75 19  
Plugging completed 5-11-75 19  
Reason for abandonment of well or producing formation Dry Hole

NORTH

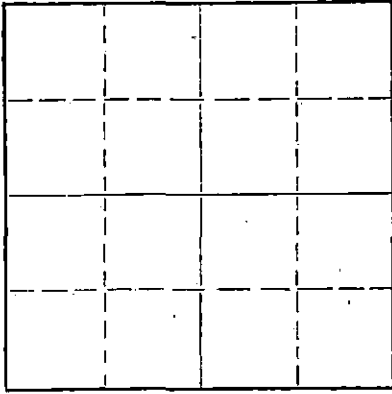

Locate well correctly on above  
Section Plat

If a producing well is abandoned, date of last production 19  
Was permission obtained from the Conservation Division or its agents before plugging was commenced? Yes

Name of Conservation Agent who supervised plugging of this well G. Russell Biberstein  
Producing formation \_\_\_\_\_ Depth to top \_\_\_\_\_ Bottom \_\_\_\_\_ Total Depth of Well 4165 Feet  
Show depth and thickness of all water, oil and gas formations.

OIL, GAS OR WATER RECORDS

CASING RECORD

FORMATION	CONTENT	FROM	TO	SIZE	PUT IN	PULLED OUT

Describe in detail the manner in which the well was plugged, indicating where the mud fluid was placed and the method or methods used in introducing it into the hole. If cement or other plugs were used, state the character of same and depth placed, from \_\_\_\_\_ feet to \_\_\_\_\_ feet for each plug set.

Plugged back to 4100 feet with sand, dumped 4 sacks cement.  
Hole full mud to 240 ft. Rock bridge 240 ft. to 230 ft.  
Cement 230 ft. to 150 ft. with 20 sacks.  
Sand 150 ft. to 20 ft.. Cement from 20 ft. to top surface with 10 sacks.

JUN 16 1975

(If additional description is necessary, use BACK of this sheet)

Name of Plugging Contractor Dewey Gressel Oil Field Contractor  
Address P. O. Box 322, Haysville, Kansas


STATE OF KANSAS, COUNTY OF SEDGWICK, ss.  
Vincent F. Hiebsch (employee of owner) or (owner or operator) of the above-described well, being first duly sworn on oath, says: That I have knowledge of the facts, statements, and matters herein contained and the log of the above-described well as filed and that the same are true and correct. So help me God.

(Signature) Vincent F. Hiebsch  
901 Union Center Bldg., Wichita, Kansas  
(Address)

SUBSCRIBED AND SWORN TO before me this 11th day of June, 1975.

Ruth N. Benjamin Notary Public.

My commission expires June 17, 1977

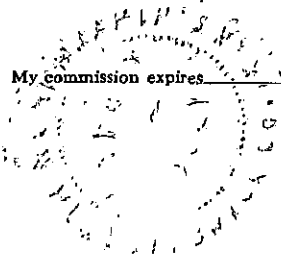

WELL LOG  
Calkin #1  
300\* N of C SE 24-29S-8W  
Kingman County, Kansas

Name of Operator: Vincent Oil Corporation  
719 Union Center Bldg.  
Wichita, Kansas 67202

Date Completed: November 29, 1972

FROM	TO	
0	307	Red bed
307	1200	Red bed and shale
1200	3388	Lime and shale
3388	4165	Lime
4165		Total Depth

RECEIVED  
STATE CORPORATION COMMISSION  
AUG 5 1974  
CONSERVATION DIVISION  
Wichita, Kansas

STATE OF KANSAS  
COUNTY OF BARTON ss

Gary L. Hawk, Secretary of Sweetman Drilling, Inc., being first duly sworn on oath says: That I have knowledge of the facts, statements and matters herein contained and the log of the above described well as filed and that the same are true and correct.

*Gary L. Hawk*  
\_\_\_\_\_  
Gary L. Hawk

Subscribed and sworn before me this 5th day of December, 1972.

*Mary Ann Schwamborn*  
\_\_\_\_\_  
Notary Public Barton County

My Commission expires 7-10-73

