


WELL PLUGGING RECORD

Give All Information Completely  
Make Required Affidavit  
Mail or Deliver Report to:  
Conservation Division  
State Corporation Commission  
211 No. Broadway  
Wichita, Kansas

NORTH

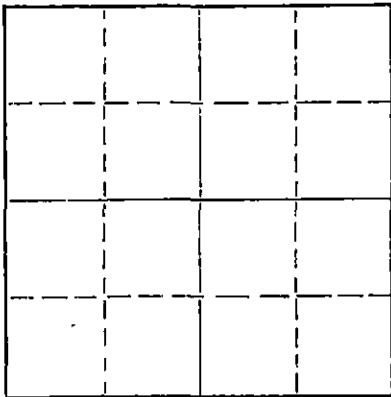

Locate well correctly on above  
Section Plat

Kingman County. Sec. 10 Twp. 29S Rge. 8 (E) W (W)  
Location as "NE/CNW/SW" or footage from lines C NW NE

Lease Owner Mack Oil Company  
Lease Name Pride Well No. 1  
Office Address 812 Union Center Building, Wichita, Kansas 67202  
Character of Well (completed as Oil, Gas or Dry Hole) Dry Hole  
Date well completed September 26 19 64  
Application for plugging filed September 26 19 64  
Application for plugging approved September 26 19 64  
Plugging commenced September 26 19 64  
Plugging completed September 27 - 1:00 p.m. 19 64  
Reason for abandonment of well or producing formation Dry

If a producing well is abandoned, date of last production \_\_\_\_\_ 19\_\_\_\_  
Was permission obtained from the Conservation Division or its agents before plugging was commenced? Yes

Name of Conservation Agent who supervised plugging of this well Archie V. Elving  
Producing formation None Depth to top \_\_\_\_\_ Bottom \_\_\_\_\_ Total Depth of Well 4600 Feet  
Show depth and thickness of all water, oil and gas formations.

OIL, GAS OR WATER RECORDS

CASING RECORD

FORMATION	CONTENT	FROM	TO	SIZE	PUT IN	PULLED OUT

Describe in detail the manner in which the well was plugged, indicating where the mud fluid was placed and the method or methods used in introducing it into the hole. If cement or other plugs were used, state the character of same and depth placed, from \_\_\_\_\_ feet to \_\_\_\_\_ feet for each plug set.

Plugged with 35 sx @ 270'  
10 sx @ 40'  
5 sx @ rathole and mousehole

RECEIVED  
STATE CORPORATION COMMISSION

OCT 1 - 1964

CONSERVATION DIVISION  
Wichita, Kansas

(If additional description is necessary, use BACK of this sheet)

Name of Plugging Contractor Mack Oil Company  
Address P. O. Box 400, Duncan, Oklahoma 73533

STATE OF KANSAS, COUNTY OF SEDGWICK, ss.  
Robert L. Harris (employee of owner) or (owner or operator) of the above-described well, being first duly sworn on oath, says: That I have knowledge of the facts, statements, and matters herein contained and the log of the above-described well as filed and that the same are true and correct. So help me God.

(Signature) Robert L. Harris  
812 Union Center Bldg., Wichita, Kansas  
(Address)

SUBSCRIBED AND SWORN TO before me this 28<sup>th</sup> day of September, 1964

My commission expires July 24, 1967  
Leroy Alder Notary Public.

MACK OIL COMPANY  
Duncan, Oklahoma

DRILLERS WELL LOG

Fride #1

Commenced R. D.: 9-14-64  
Completed R. D.: 9-26-64  
Total Depth: 4600'

C NW NE Section 10-29S-8W  
Kingman County, Kansas  
Elevation: 1684' K.B.  
Initial Production: Dry  
Contractor: Mack Oil Company

STRATA	DEPTH
Top Soil & Clay	0 - 45
Sand	45 - 70
Red Bed & Sand	70 - 145
Shale	145 - 800
Shale & Lime	800 - 1000
Shale & Sand	1000 - 1085
Shale & Lime	1085 - 1665
Lime	1665 - 1818
Lime & Shale	1818 - 2035
Shale & Lime Shells	2035 - 2347
Lime & Shale	2347 - 2547
Shale with Lime Streaks	2547 - 2645
Shale & Shells	2645 - 2935
Shale with Lime Streaks	2935 - 3000
Lime & Chalky Shale	3000 - 3155
Lime	3155 - 3502
Lime & Shale	3502 - 3574
Lime	3574 - 3770
Lime & Chert	3770 - 3807
Lime	3807 - 4195
Chat	4195 - 4212
Chert & Lime	4212 - 4261
Cherty Lime	4261 - 4292
Lime	4292 - 4327
Cherty Lime	4327 - 4358
Lime	4358 - 4386
Lime & Shale	4386 - 4514
Viola Lime	4514 - 4521
Simpson	4521 - 4545
Simpson Sand	4545 - 4600'

RECEIVED  
STATE CORPORATION COMMISSION

SEP 29 1964

CONSERVATION DIVISION  
Wichita, Kansas

I hereby certify that the above is a true and correct log of said well as reflected by the daily drilling reports.

MACK OIL COMPANY

By Robert L. Harris  
Robert L. Harris

Signed and sworn to in my presence this 28th day of September, 1964,  
by Robert L. Harris, representative of Mack Oil Company.

Living Alder  
Notary Public

My commission expires: July 24, 1967