

STATE OF KANSAS
STATE CORPORATION COMMISSION

WELL PLUGGING RECORD

Give All Information Completely
Make Required Affidavit
Mail or Deliver Report to
Conservation Division
State Corporation Comm.
245 North Water
Wichita, KS 67202

Kingman County, Sec. 9 Twp. 29S Rge. 8 xE/W
Location as "NE/CNW 1/4 SW 1/4" or footage from lines
NE SW SW

Lease Owner Keener Oil Company
Lease Name John Demmer Well No. 1
Office Address 406 National Bk of Tulsa Bldg. - Tulsa, Okla.
Character of Well (Completed as Oil, Gas or Dry Hole)


Dry Hole

Date Well completed March 2, 1978
Application for plugging filed March 2, 1978
Application for plugging approved March 2, 1978
Plugging commenced March 2, 1978
Plugging completed March 2, 1978
Reason for abandonment of well or producing formation
dry hole

If a producing well is abandoned, date of last production
19

Was permission obtained from the Conservation Division or
its agents before plugging was commenced? yes

Name of Conservation Agent who supervised plugging of this well Bill Owen - Pratt, Kansas
Producing formation Depth to top Bottom Total Depth of Well 4215
Show depth and thickness of all water, oil and gas formations.

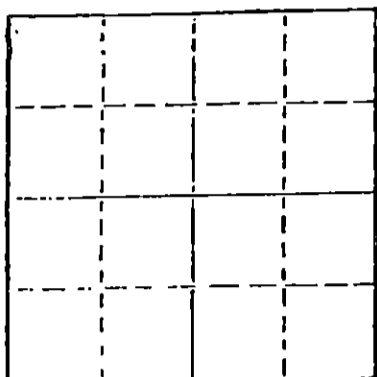

Locate well correctly on above
Section Plot

OIL, GAS OR WATER RECORDS

CASING RECORD

FORMATION	CONTENT	FROM	TO	SIZE	PUT IN	PULLED OUT
	Surface					
	Casing	0	202	8 5/8	202	none

Describe in detail the manner in which the well was plugged, indicating where the mud fluid was placed and the method or methods used in introducing it into the hold. If cement or other plugs were used, state the character of same and depth placed, from feet to feet for each plug set.

Plugged with 40 sacks at 210'
12 sacks at 40', 3 sacks in rat hole.
Job completed March 2, 1978 at 1:00 P.M.

RECEIVED
STATE CORPORATION COMMISSION
MAR 06 1978
CONSERVATION DIVISION
Wichita, Kansas

(If additional description is necessary, use BACK of this sheet)

Name of Plugging Contractor Search Drilling Company
P. O. Box 18148 - Wichita, Kansas 67218

STATE OF Kansas COUNTY OF Sedgwick, ss.
R. M. Stagl (employee of owner) or (owner or operator
of the above-described well, being first duly sworn on oath, says: That I have knowledge of
the facts, statements, and matters herein contained and the log of the above-described well
as filed and that the same are true and correct. So help me God.

(Signature) R. M. Stagl
Wichita, Kansas
(Address)

SUBSCRIBED AND SWORN TO before me this 2 day of March, 19 78

Maxine Dressen
Notary Public.

My commission expires February 22, 1981



DRILLERS LOG

JOHN DEMMER #1

CASING RECORD:
8 5/8" set at 202'
with 175 sacks cement

OPERATOR: Keener Oil Company

DESCRIPTION

CONTRACTOR: Search Drilling Company

NE SW SW
Section 9-29S-8W
Kingman County,
Kansas

TOTAL DEPTH:
4215'

COMMENCED: February 25, 1978

COMPLETED: March 2, 1978

<u>FORMATION</u>	<u>FROM</u>	<u>TO</u>	<u>REMARKS</u>
Sand	0	230	
Red Bed and Shale	230	1209	
Lime and Shale	1209	1625	
Lime and Shale	1625	2657	
Lime and Shale	2657	3623	
Lime and Shale	3623	4181	
Lime and Shale	4181	4215	
Rotary Total Depth	4215		Dry and Abandoned


I certify that this is a true and correct copy of the above log to the best of my knowledge.

SEARCH DRILLING COMPANY

R. M. Stagl
R. M. Stagl

Subscribed and sworn to before me this 2nd day of March, 1978

My appointment expires:
February 22, 1981

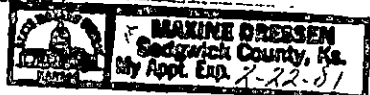

Maxine Dressen
Maxine Dressen Notary Public

RECEIVED
STATE CORPORATION COMMISSION
MAR 06 1978
CONSERVATION DIVISION
Wichita, Kansas