

15-095-00483-0000

STATE OF KANSAS
STATE CORPORATION COMMISSION


Form CP-4

WELL PLUGGING RECORD

Give All Information Completely
Make Required Affidavit
Mail or Deliver Report to:
Conservation Division
State Corporation Commission
211 No. Broadway
Wichita, Kansas

Kingman County. Sec. 8 Twp. 29S Rge. (E) 8 (W)
Location as "NE/CNWxSWx" or footage from lines C NE SE
Lease Owner Pickrell Drilling Company
Lease Name Schuman "A" Well No. 1
Office Address 705 4th National Bank Building, Wichita, Kansas
Character of Well (completed as Oil, Gas or Dry Hole) Dry Hole
Date well completed September 6, 1964
Application for plugging filed September 6, 1964
Application for plugging approved September 6, 1964
Plugging commenced September 6, 1964
Plugging completed September 6, 1964
Reason for abandonment of well or producing formation Dry Hole

NORTH

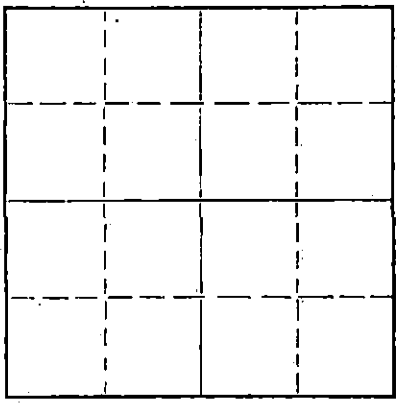

Locate well correctly on above Section Plat

If a producing well is abandoned, date of last production _____ 19____
Was permission obtained from the Conservation Division or its agents before plugging was commenced? Yes

Name of Conservation Agent who supervised plugging of this well Archie V. Elving
Producing formation _____ Depth to top _____ Bottom _____ Total Depth of Well 4518 Feet
Show depth and thickness of all water, oil and gas formations.

OIL, GAS OR WATER RECORDS

CASING RECORD

| FORMATION | CONTENT | FROM | TO | SIZE | PUT IN | PULLED OUT |
|-----------|---------|------|----|-------|--------|------------|
| | | | | 8 5/8 | 210' | None |
| | | | | | | |
| | | | | | | |
| | | | | | | |
| | | | | | | |
| | | | | | | |
| | | | | | | |
| | | | | | | |

Describe in detail the manner in which the well was plugged, indicating where the mud fluid was placed and the method or methods used in introducing it into the hole. If cement or other plugs were used, state the character of same and depth placed, from _____ feet to _____ feet for each plug set.

Heavy mud to 210', set plug, cemented with 25 sacks cement.
Heavy mud to 40', set plug, cemented with 10 sacks cement
to bottom of cellar. Plugged rat hole with 2 sacks cement.

RECEIVED
STATE CORPORATION COMMISSION

SEP 21 1964

CONSERVATION DIVISION
Wichita, Kansas

(If additional description is necessary, use BACK of this sheet)
Name of Plugging Contractor Pickrell Drilling Company
Address 705 4th National Bank Building, Wichita, Kansas

STATE OF KANSAS, COUNTY OF SEDGWICK, ss.

C. W. Sebitts ~~XXXXXX~~ (owner or operator) of the above-described well, being first duly sworn on oath, says: That I have knowledge of the facts, statements, and matters herein contained and the log of the above-described well as filed and that the same are true and correct. So help me God.

(Signature) C. W. Sebitts
705 4th National Bank Building, Wichita, Kansas
(Address)

SUBSCRIBED AND SWORN TO before me this 9th day of September, 19 64

My commission expires June 21, 1966

Maxine Blackman
Maxine Blackman, Notary Public.

ROTARY DRILLING LOG

COMPANY: PICKRELL DRILLING COMPANY
705 4th National Bank Building
Wichita, Kansas
LOCATION: C NE SE Section 8-29-8W, Kingman County, Kansas
SCHUMAN "A" No. 1

Rotary Drilling Commenced 8-23-64
Rotary Drilling Completed 9--6-64

CONTRACTOR: **PICKRELL DRILLING COMPANY**
Wichita, Kansas

CASING RECORD: (10 jts) 8 5/8" surface casing set at 210', cemented with 155 sacks cement. Circulated. Completed 4:15 P.M. August 23, 1964. No oil string run, D & A.

LOG

(Figures indicate bottom of formation — measurements from top of rotary bushing.)

| | | <u>C. F. S.</u> |
|------|---------------------|-----------------|
| 68 | Sand & Clay | |
| 211 | Red Rock | 3480 |
| 1010 | Shale & Shells | 3490 |
| 1795 | Lime & Shale | 3519 |
| 1940 | Lime | 3863 |
| 2920 | Shale & Lime | 3895 |
| 3014 | Lime | 3900 |
| 3310 | Lime & Shale | 3905 |
| 3491 | Lime & Shale & Sand | 4174 |
| 3522 | Lansing | 4184 |
| 3905 | Lime | 4460 |
| 4180 | Lime & Shale | 4470 |
| 4383 | Mississippi | 4465 |
| 4483 | Kinderhook | 4489 |
| 4518 | Viola - RTD | 4486 |
| | | 4494 |
| | | 4499 |
| | | 4504 |
| | | 4518 |

Slope Tests
2500
3000
3500
4000

S. L. M.
3585
4037
3308
4308
RECEIVED
STATE CORPORATION COMMISSION

SEP 21 1964

CONSERVATION DIVISION
Wichita, Kansas

The undersigned, C. W. SEBITS, Attorney-in-Fact for PICKRELL DRILLING COMPANY, hereby certifies in behalf of said Company, that the above is a true and correct log of the formation encountered in drilling the above well as reflected by the Daily Drilling Reports.

PICKRELL DRILLING COMPANY
By [Signature]
C. W. SEBITS Attorney-in-Fact

STATE OF KANSAS }
COUNTY OF SEDGWICK } ss.:

On this 9th day of September, 19 64, before me the undersigned, a Notary Public, in and for the County and State aforesaid, personally appeared C. W. SEBITS, to me known to be the identical person who subscribed the name of PICKRELL DRILLING COMPANY to the foregoing instrument as its Attorney-in-Fact and acknowledged to me that he executed the same as his free and voluntary act and deed, and as the free and voluntary act and deed of such company, for the uses and purposes therein set forth.

Given under my hand and seal of office the day and year last above written.

My commission expires: June 21, 1966

[Signature]
Maxine Blackman, Notary Public