


STATE OF KANSAS  
STATE CORPORATION COMMISSION

WELL PLUGGING RECORD

Give All Information Completely  
Make Required Affidavit  
Mail or Deliver Report to:  
Conservation Division  
State Corporation Commission  
211 No. Broadway  
Wichita, Kansas

Kingman County. Sec. 7 Twp. 29 Rge. (E) 8 (W)  
Location as "NE/CNW%SW%" or footage from lines C/ SE/4 SW  
Lease Owner Graham - Michaelis Drilling Co.  
Lease Name Herman Oeding Well No. 1  
Office Address 211 North Broadway, Wichita, Kansas  
Character of Well (completed as Oil, Gas or Dry Hole) Dry Hole  
Date well completed 11-26-56 19  
Application for plugging filed 11-26-56 19  
Application for plugging approved 11-26-56 19  
Plugging commenced 11-26-56 19  
Plugging completed 11-26-56 19  
Reason for abandonment of well or producing formation Dry Hole

NORTH

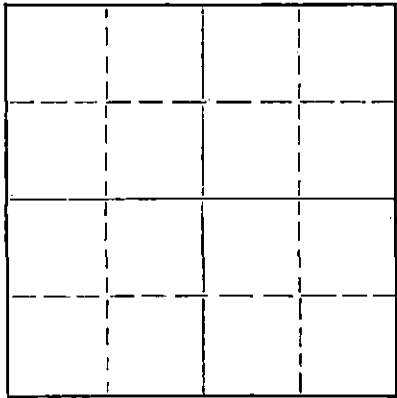

Locate well correctly on above  
Section Plat

If a producing well is abandoned, date of last production \_\_\_\_\_ 19\_\_\_\_  
Was permission obtained from the Conservation Division or its agents before plugging was commenced? Yes

Name of Conservation Agent who supervised plugging of this well M. A. Rives, Box 8, Pratt, Kansas  
Producing formation \_\_\_\_\_ Depth to top \_\_\_\_\_ Bottom \_\_\_\_\_ Total Depth of Well 4,524 Feet  
Show depth and thickness of all water, oil and gas formations.

OIL, GAS OR WATER RECORDS

CASING RECORD

FORMATION	CONTENT	FROM	TO	SIZE	PUT IN	PULLED OUT
Sand & Red Bed		0	226*	8 5/8"	226*	0*

Describe in detail the manner in which the well was plugged, indicating where the mud fluid was placed and the method or methods used in introducing it into the hole. If cement or other plugs were used, state the character of same and depth placed, from \_\_\_\_\_ feet to \_\_\_\_\_ feet for each plug set.

Plugged hole. Filled hole to 220\* W/heavy mud. Bottom plug @ 220\* W/20  
sacks cement. Filled hole to 35\*. Top plug @ 35\* W/ 1/4 sack hulls  
10 sacks cement.

(If additional description is necessary, use BACK of this sheet)

Name of Plugging Contractor GRAHAM - MICHAELIS DRILLING CO.  
Address \_\_\_\_\_

STATE OF KANSAS COUNTY OF SEDGWICK SS.  
V. D. Grier (employee of owner) or (owner or operator) of the above-described well, being first duly sworn on oath, says: That I have knowledge of the facts, statements, and matters herein contained and the log of the above-described well as filed and that the same are true and correct. So help me God. GRAHAM - MICHAELIS DRILG. CO.

(Signature) V. D. Grier  
211 North Broadway, Wichita, Kansas  
(Address)

SUBSCRIBED AND SWORN TO before me this 29th day of November 19 56

My commission expires 11/7/57.

RECEIVED  
STATE CORPORATION COMMISSION  
W. S. Barnes  
Notary Public.

PLUGGING  
FILE SEC 7 T 29 R 8 SW  
BOOK PAGE 120 LINE 19  
NOV 30 1956 11-30-56  
CONSERVATION DIVISION  
Wichita, Kansas

HERMAN OEDING #1

Well Record

Location: C. SE/4 SE/4 Sec. 7-T298-R8W Kingman County, Kansas  
 Commenced: November 10, 1956  
 Completed: November 25, 1956 (rotary)

Operator: Graham - Michaelis Drilling Co.  
 211 North Broadway  
 Wichita, Kansas

Contractor: Graham - Michaelis Drilling Co.  
 211 North Broadway  
 Wichita, Kansas

Casing Record: 8 5/8" @ 226' w/150 sacks cement

LOG

Sand	80
Red Bed	375
Shale	645
Shale & Shells	1080
Shale & Lime Stks.	1245
Shale & Lime	1500
Lime & Shale	1647
Lime	1661
Shale & Lime	1747
Lime	1804
Lime & Shale	2025
Shale & Lime	2112
Sand & Shale	2137
Lime & Shale	2575
Shale & Lime	2710
Lime & Shale	2820
Shale	2866
Shale & Lime	2976
Lime	3020
Lime & Shale	3210
Lime	3323
Shale	3420
Lime	3443
Shale - Lime - Sand	3533
Lime & Shale	3555
Lime Chalky & Shale	3565
Lime	3951
Lime & Shale	4200
Miss.	4205
Miss. Chert	4316
Miss. Chert & Lime	4337
Miss. Lime	4362
Shale	4504
Viola Chert-Lime	4525

RECORDED  
 STATE CORPORATION DIVISION  
 NOV 25 1956

CONSERVATION DIVISION  
 WICHITA, KANSAS

STATE OF KANSAS )  
 ) ss.  
 COUNTY OF SEDGWICK)

The undersigned, GRAHAM - MICHAELIS DRILLING COMPANY, hereby certifies that the above log is a true and correct log of the formations encountered in drilling the above well as reflected by the Daily Drilling Report.

GRAHAM - MICHAELIS DRILLING COMPANY

By John L. James  
 John L. James, Geologist.

Subscribed and sworn to before me this 28th day of November, 1956.

Mary L. Barnes  
 My commission expires: 11/1/57.

PLUGGING  
 FILE SEC 7 T 29 R 8W  
 BOOK PAGE 120 LINE 19