

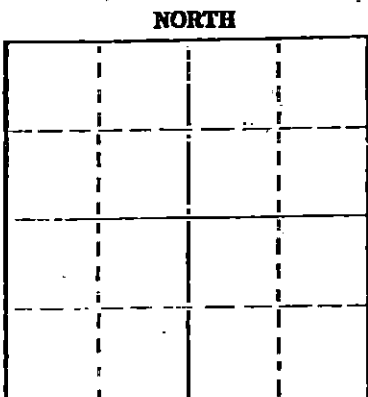
STATE OF KANSAS
STATE CORPORATION COMMISSION
CONSERVATION DIVISION
P. O. BOX 17027
WICHITA, KANSAS 67217

FORM CP-4

WELL PLUGGING RECORD

Kingman County, Sec. 24 Twp 30 Rgn 6W (E) (W)

Location as "NE/CNWSW" or footage from lines NE NW
Lease Owner PICKRELL DRILLING COMPANY
Lease Name Fieser "G" Well No. 1
Office Address 705 4th National Bank Bldg. Wichita, Ks. 67202
Character of Well (completed as Oil, Gas or Dry Hole) Dry Hole
Date well completed 8-21 1975
Application for plugging filed 8-21 1975
Application for plugging approved 8-21 1975
Plugging commenced 8-21 1975
Plugging completed 8-21 1975
Reason for abandonment of well or producing formation Dry Hole



Locate well correctly on above Section Plat

If a producing well is abandoned, date of last production 19
Was permission obtained from the Conservation Division or its agents before plugging was commenced? Yes

Name of Conservation Agent who supervised plugging of this well G. R. Biberstein
Producing formation _____ Depth to top _____ Bottom _____ Total Depth of Well 4558
Show depth and thickness of all water, oil and gas formations.

OIL, GAS OR WATER RECORDS

CASING RECORD

FORMATION	CONTENT	FROM	TO	SIZE	PUT IN	PULLED OUT
				8 5/8	212	None

Describe in detail the manner in which the well was plugged, indicating where the mud fluid was placed and the method or methods used in introducing it into the hole. If cement or other plugs were used, state the character of same and depth placed, from _____ feet to _____ feet for each plug set.

RECEIVED
STATE CORPORATION COMMISSION
SEP 03 1975
CONSERVATION DIVISION
Wichita, Kansas

35 sx. at 200'
15 sx at 40'
2 sx. in Rat Hole Job comp. 10PM 8-21-75

Name of Plugging Contractor PICKRELL DRILLING COMPANY
Address 705 4th Nat'l Bank Bldg. Wichita, Ks. 67202

STATE OF Kansas COUNTY OF Sedgwick ss.

C. W. Sebitts (employee of owner) or (owner or operator) of the above-described well, being first duly sworn on oath, says: That I have knowledge of the facts, statements, and matters herein contained and the log of the above-described well as filed and that the same are true and correct. So help me God.

(Signature) C. W. Sebitts
705 4th Nat'l Bk. Bldg.
(Address) Wichita, Ks. 67202

SUBSCRIBED AND SWORN TO before me this 28 day of August, 1975

My commission expires _____
STATE NOTARY PUBLIC
HELEN L. MARTIN
Sedgwick County, Ks.
My Appmt. Exp. Aug. 19, 1977

Helen L. Martin
Helen L. Martin
Notary Public.

COMPANY: PICKRELL DRILLING COMPANY
 705 4th Nat'l Bank Bldg.
 Wichita, Ks. 67202
 LOCATION: Fieser "G"
 NE NW 24-30-6W
 Kingman Co., Ks.
 CONTRACTOR: PICKRELL DRILLING COMPANY
 Wichita, Kansas

Rotary Drilling Commenced 8-11-75
 Rotary Drilling Completed 8-21-75

CASING RECORD: 8 5/8 surface pipe. Set at 212' with 165 sacks cement. Job comp. 8-11.

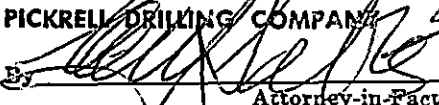
LOG

(Figures indicate bottom of formation — measurements from top of rotary bushing.)

Sand	72
Sand	225
Red Beds	360
Shale & Shell	425
Shale	920
Shale w/Lime Stks.	1100
Shale w/Lime Stks.	1360
Shale w/Lime	1530
Shale w/Lime	1595
Shale & Lime	1835
Shale & Lime	1950
Shale & Lime	2155
Lime & Shale	2335
Shale & Lime	2585
Shale & Lime	2870
Shale & Lime	2980
Shale & Lime	3230
Shale & Lime & Sand	3425
Lime & Shale	3570
Lime & Shale	3660
Shale & Lime	3780
Shale & Lime	3830
Lime & Shale	3910
Lime & Shale	4010
Lime & Shale	4115
Lime & Shale	4195
Lime-Shale	4355
Lime & Shale	4375
Shale & Lime	4425
Lime & Shale	4508
Shale & Lime	4518
Lime & Shale	4550
Sand	4558

RECEIVED
 STATE CORPORATION COMMISSION
 SEP 03 1975
 CONSERVATION DIVISION
 Wichita, Kansas

The undersigned, C. W. Sebitts, Attorney-in-Fact for PICKRELL DRILLING COMPANY, hereby certifies in behalf of said Company, that the above is a true and correct log of the formation encountered in drilling the above well as reflected by the Daily Drilling Reports.

PICKRELL DRILLING COMPANY

 Attorney-in-Fact
 C. W. Sebitts

STATE OF KANSAS }
 COUNTY OF SEDGWICK } ss.:

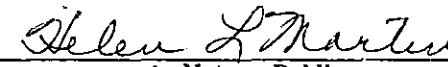
On this 28 day of August, 19 75, before me the undersigned, a Notary Public, in and for

the County and State aforesaid, personally appeared C. W. Sebitts, to me known to be the identical person who subscribed the name of PICKRELL DRILLING COMPANY to the foregoing instrument as its Attorney-in-Fact and acknowledged to me that he executed the same as his free and voluntary act and deed, and as the free and voluntary act and deed of such company, for the uses and purposes therein set forth.

Given under my hand and seal of office the day and year last above written.

My commission expires


 HELEN L. MARTIN
 Sedgwick County, Ks.
 My Appmt. Exp. Aug. 19, 1977


 Helen L. Martin Notary Public