


STATE OF KANSAS
STATE CORPORATION COMMISSION

WELL PLUGGING RECORD

Give All Information Completely
Make Required Affidavit
Mail or Deliver Report to
Conservation Division
State Corporation Comm.
245 North Water
Wichita, KS 67202

Kingman County, Sec. 22 Twp. 30S Rge. 6W E/W
Location as "NE/CNW $\frac{1}{4}$ SW $\frac{1}{4}$ " or footage from lines
C- NE - NW - 660 FNL 1980 FWL

Lease Owner Texas Oil & Gas Corp.
Lease Name Cragon Well No. 1
Office Address 200 W. Douglas, Suite 300 Wichita, Kansas
Character of Well (Completed as Oil, Gas or Dry Hole)

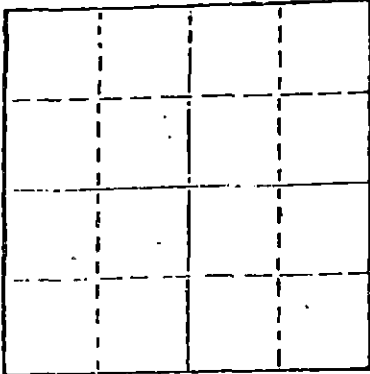

Locate well correctly on above Section Plat

Gas
Date Well completed 1 - 28 1977
Application for plugging filed 10 - 4 1979
Application for plugging approved 10 - 5 1979
Plugging commenced 11 - 27 1979
Plugging completed 12 - 5 1979
Reason for abandonment of well or producing formation

Not Productive
If a producing well is abandoned, date of last production 19

Was permission obtained from the Conservation Division or its agents before plugging was commenced? Yes

Name of Conservation Agent who supervised plugging of this well Bill Owens
Producing formation Depth to top Bottom Total Depth of Well 4620
Show depth and thickness of all water, oil and gas formations.

OIL, GAS OR WATER RECORDS

CASING RECORD

FORMATION	CONTENT	FROM	TO	SIZE	PUT IN	PULLED OUT
				8 5/8	262	None
				4 1/2	2030	1581

Describe in detail the manner in which the well was plugged, indicating where the mud fluid was placed and the method or methods used in introducing it into the hold. If cement or other plugs were used, state the character of same and depth placed, from feet to feet for each plug set.

Sand from 2003 to 1900
4 Sacks cement from 1900 to 1860
Ripped at 1680 and 1581
Pulled 1581 layed down
Pump in 5 sacks Hull
20 sacks Jell
100 sacks 50-50 POZ 4% Gel

STATE RECEIVED
CONSERVATION COMMISSION
DEC 18 1979
Wichita, Kansas

(If additional description is necessary, use BACK of this sheet)

Name of Plugging Contractor Clarke Corporation

STATE OF Kansas COUNTY OF Barber, ss.
Elmer K. Mergentern (employee of owner) or (owner or operator)
of the above-described well, being first duly sworn on oath, says: That I have knowledge of the facts, statements, and matters herein contained and the log of the above-described well as filed and that the same are true and correct. So help me God.

(Signature) Elmer K. Mergentern
Medicine Lodge, Kansas
(Address)

SUBSCRIBED AND SWORN TO before me this 5th day of December, 1979

Jessie Hamilton
Notary Public.

My commission expires April 4, 1982.

DRILLER'S LOG

Bl
DF
GWB
RI

COMPANY: Texas Oil & Gas Corporation

SEC. 22 T. 30S R. 6W

WELL NAME: Cragun #1

LOC. 660' FNL & 1980' FWL

COUNTY: Kingman

RIG NO. #3

TOTAL DEPTH 4620'

ELEVATION

COMMENCED: 1-15-77 COMPLETED: 1-28-77

CONTRACTOR: Rains & Williamson Oil Co., Inc.

CASING RECORD:

SURFACE: 8 5/8" @262' w/150 sx. Lite, 2% gel, 3% cc. and 100 sx. Common, 2% gel, 3% cc. and 100 sx. Lite, 2% gel, 3% cc.

PRODUCTION: 4 1/2" @2027' w/125 sx. 50/50 poz.

LOG

(Figures Indicate Bottom of Formations)

Sand & Shale	72
Shale	264
Shale & Lime	1452
Lime & Shale	1592
Shale & Lime	1900
Lime & Shale	1968
Shale & Lime	2255
Lime & Shale	2448
Shale & Lime	2857
Lime & Shale	3711
Lime	4620
<u>ROTARY TOTAL DEPTH</u>	<u>4620</u>

RECEIVED
STATE CORPORATION COMMISSION

OCT - 5 1979

CONSERVATION DIVISION
Wichita, Kansas

STATE OF Kansas)
COUNTY OF Sedgwick) SS:

I, Wilson Rains, President of Rains & Williamson Oil Co., Inc.
upon oath state that the above and foregoing is a true and correct copy of the log of the
Cragun #1 well.

Wilson Rains
Wilson Rains

Subscribed and sworn to before me this 1 day of February, 1979.

My Appointment Expires:
10-4-79

Juanita M. Green
Juanita M. Green




15-095-20549-0000

WELL : CRAGUN #1

LOCATION : 660 PNL + 1980' FWL 22-305-6W Kingman Co, Ks

ELEVATION : 1372' G.L. 1381' K.B.

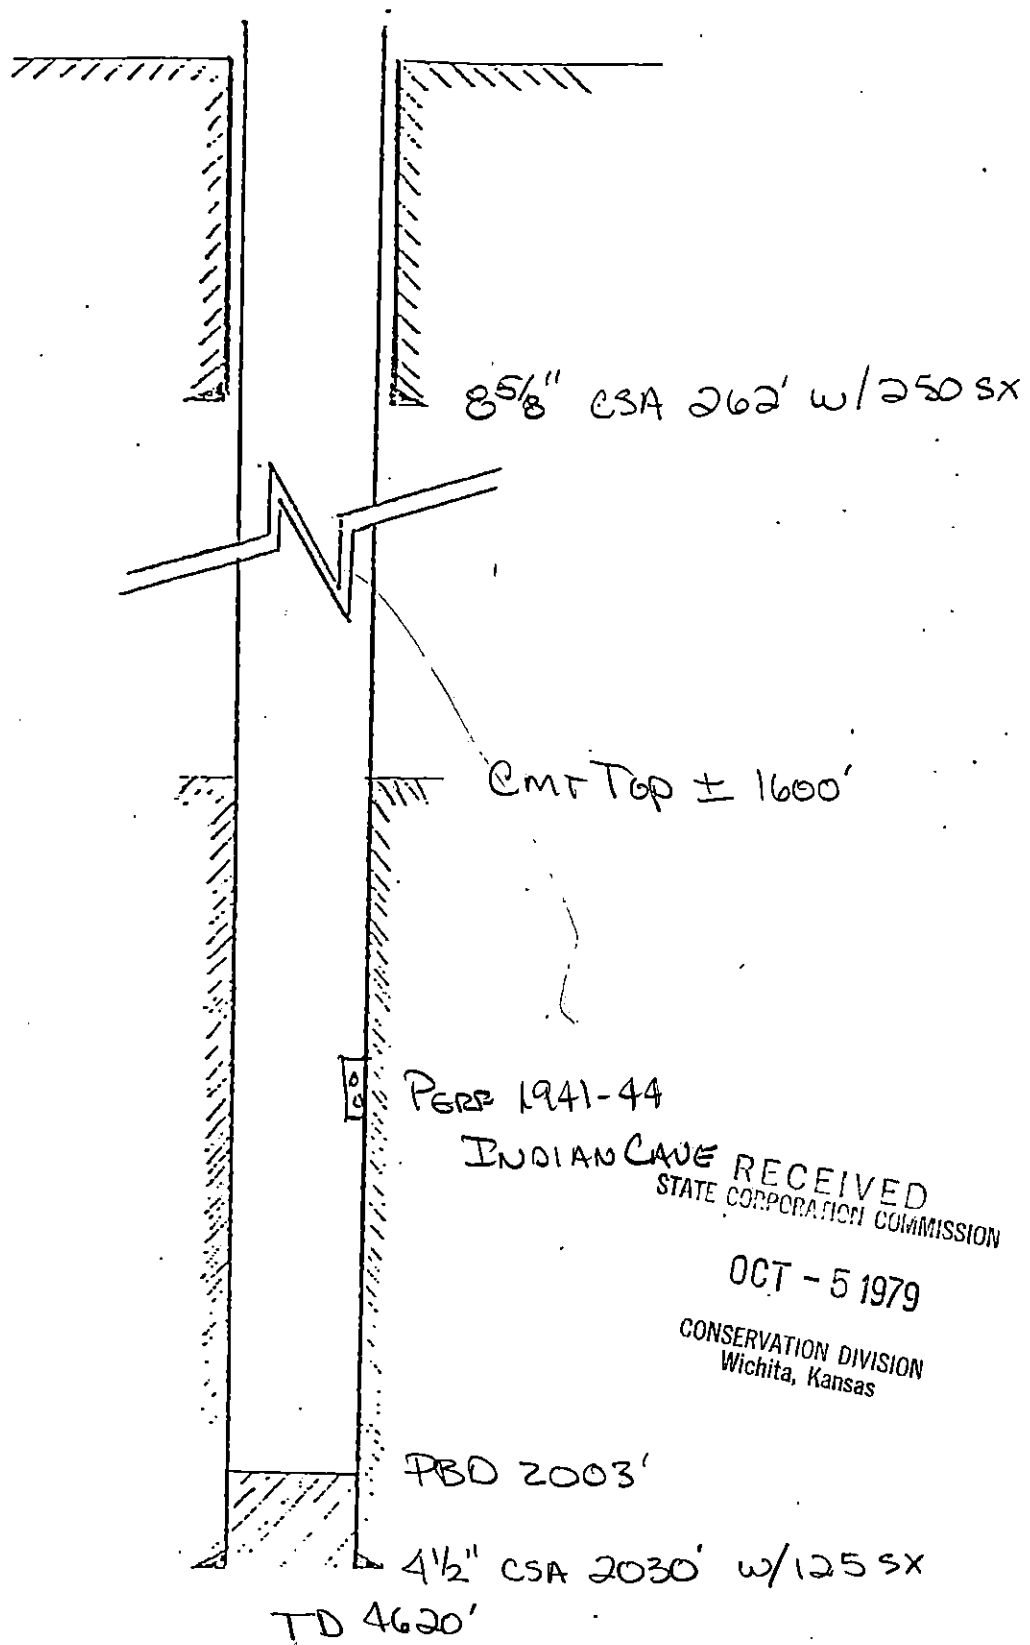

INDIAN CAVE RECEIVED
STATE CORPORATION COMMISSION
OCT - 5 1979
CONSERVATION DIVISION
Wichita, Kansas