


STATE OF KANSAS  
STATE CORPORATION COMMISSION

Form CP-4

Give All Information Completely  
Make Required Affidavit  
Mail or Deliver Report to:  
Conservation Division  
State Corporation Commission  
212 No. Market  
Wichita, Kansas 67202

WELL PLUGGING RECORD

NORTH

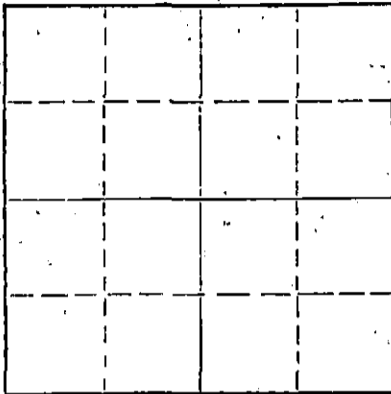

Locate well correctly on above  
Section Plat

Kingman County, Sec. 22, Twp. 30S, Rge. 6 (E) W (W)  
Location as "NE/CNW/SW" or footage from lines C NW SE  
Lease Owner Bell Oil Company  
Lease Name Henry Allphin Well No. 1  
Office Address 562 Wetmore Ct., Wichita, Ks.  
Character of Well (completed as Oil, Gas or Dry Hole) D&A  
Date well completed 11/23 19 71  
Application for plugging filed 11/23 19 71  
Application for plugging approved 11/23 19 71  
Plugging commenced 11/23 19 71  
Plugging completed 11/23 19 71  
Reason for abandonment of well or producing formation D&A

If a producing well is abandoned, date of last production 19  
Was permission obtained from the Conservation Division or its agents before plugging was commenced? Yes

Name of Conservation Agent who supervised plugging of this well G.R. Biberstein  
Producing formation \_\_\_\_\_ Depth to top \_\_\_\_\_ Bottom \_\_\_\_\_ Total Depth of Well 4525 Feet  
Show depth and thickness of all water, oil and gas formations.

OIL, GAS OR WATER RECORDS

CASING RECORD

FORMATION	CONTENT	FROM	TO	SIZE	PUT IN	PULLED OUT
				8 5/8"	263'	-0-

Describe in detail the manner in which the well was plugged, indicating where the mud fluid was placed and the method or methods used in introducing it into the hole. If cement or other plugs were used, state the character of same and depth placed, from \_\_\_\_\_ feet to \_\_\_\_\_ feet for each plug set.

Fill hole to 250' w/mud, 1/2 sx Hulls,  
plug 35 sx cement, Mud to 40', 1/2 sx  
hulls, plug 10 sx cement, 2 sx rathole.


RECEIVED  
STATE CORPORATION COMMISSION  
MAR 13 1972  
CONSERVATION DIVISION  
Wichita, Kansas

(If additional description is necessary, use BACK of this sheet)  
Name of Plugging Contractor Red Tiger Drilling Co.  
Address 1720 Wichita Plaza, Wichita, Ks.

STATE OF Kansas, COUNTY OF Sedgwick, ss.  
Jim Farrice (employee of owner) or (owner or operator) of the above-described well, being first duly sworn on oath, says: That I have knowledge of the facts, statements, and matters herein contained and the log of the above-described well as filed and that the same are true and correct. So help me God.

(Signature) Jim Farrice  
1720 Wichita Plaza, Wichita, Ks.  
(Address)

SUBSCRIBED AND SWORN to before me this 29th day of November, 19 71

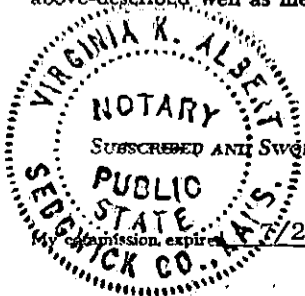

Virginia K. Albert  
Notary Public.

DRILLERS LOG

No. 1 Henry Allphin

CASING RECORD:

8 5/8" @ 263'  
w/200 sx cement

COMPANY:

Bell Oil Company

DESCRIPTION:

C NW SE  
22-308-6W  
Kingman County,  
Kansas

CONTRACTOR:

Red Tiger Drilling Company

COMMENCED:

November 11, 1971

COMPLETED:

November 23, 1971

TOTAL DEPTH: 4525'

ELEVATION:

<u>FORMATION</u>	<u>FROM</u>	<u>TO</u>	<u>REMARKS</u>
Sand & Gravel	0	30	
Shale & Red Bed	30	265	
Red Bed	265	320	
Shale & Shells	320	740	
Red Bed & Shale	740	785	
Lime	785	788	
Shale & Shells	788	919	
Lime & Shale	919	2525	
Shale	2525	2586	
Lime (Topeka)	2586	2720	
Lime & Shale	2720	2900	
Lime	2900	2965	
Shale	2965	2969	
Lime	2969	3010	
Shale & Lime	3010	3487	
Lime	3487	3495	
Shale	3495	3508	
Lime	3508	3752	
Lime & Shale	3752	3960	
Gummy Shale & Lime	3960	4016	
Lime & Shale	4016	4080	
Miss	4080	4225	
Cherty Lime	4225	4290	
Miss	4290	4355	
Kinderhook	4355	4395	
Shale	4395	4460	
Kinderhook	4460	4500	
Kinderhook-Misener-Viola	4500	4525	

RECEIVED  
STATE CORPORATION COMMISSION  
JUL 26 1972  
CONSERVATION DIVISION  
Wichita, Kansas

I certify that this is a true and correct copy of the above log to the best of my knowledge.

RED TIGER DRILLING COMPANY

Jim Farrice  
Jim Farrice

Subscribed and sworn to before me this 29th day of November, 1971.

Signe Albert  
Notary Public

NOTARY PUBLIC  
STATE OF KANSAS  
My Commission Expires:  
July 20, 1974