


STATE OF KANSAS  
STATE CORPORATION COMMISSION

WELL PLUGGING RECORD

Give All Information Completely  
Make Required Affidavit  
Mail or Deliver Report to  
Conservation Division  
State Corporation Comm.  
245 North Water  
Wichita, KS 67202

Kingman County. Sec. 21 Twp. 30S Rge. 6W ~~XXX~~  
Location as "NE/CNW $\frac{1}{4}$ /SW $\frac{1}{4}$ " or footage from lines \_\_\_\_\_  
NE SE

Lease Owner Halliburton Oil Producing Company  
Lease Name Boileau Well No. 1  
Office Address 2915 Classen Blvd Oklahoma City Okla.  
Character of Well (Completed as Oil, Gas or Dry Hole) \_\_\_\_\_  
Dry Hole

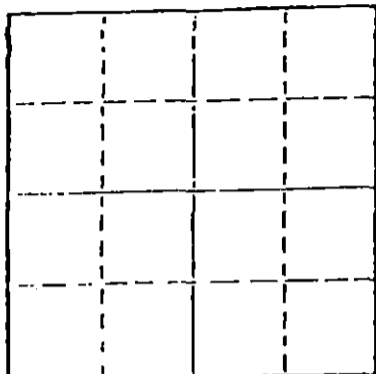

Locate well correctly on above  
Section Plot

Date Well completed September 10, 1977  
Application for plugging filed Verbal Application 1977  
Application for plugging approved Verbal Approval 1977  
Plugging commenced September 9, 1977  
Plugging completed September 10, 1977  
Reason for abandonment of well or producing formation \_\_\_\_\_

If a producing well is abandoned, date of last production \_\_\_\_\_ 19\_\_

Was permission obtained from the Conservation Division or its agents before plugging was commenced? Yes

Name of Conservation Agent who supervised plugging of this well William T. Owen  
Producing formation \_\_\_\_\_ Depth to top \_\_\_\_\_ Bottom \_\_\_\_\_ Total Depth of Well 4,535  
Show depth and thickness of all water, oil and gas formations.

OIL, GAS OR WATER RECORDS

CASING RECORD

FORMATION	CONTENT	FROM	TO	SIZE	PUT IN	PULLED OUT
				8 5/8"	283'	None

Describe in detail the manner in which the well was plugged, indicating where the mud fluid was placed and the method or methods used in introducing it into the hold. If cement or other plugs were used, state the character of same and depth placed, from \_\_\_\_\_ feet to \_\_\_\_\_ feet for each plug set.

Filled hole with heavy rotary mud from 4,535 ft. (rotary total depth) to 300 ft. Set plug at 300 ft. and cemented with 40 sacks cement.

Filled hole with heavy rotary mud from 300 ft. to 40 ft. Set solid plug at 40 ft. and cemented to cellar with 12 sacks cement, 5 sacks cement in rat hole.

Plugging operations accomplished utilizing Halliburton Oil Well Cementing pump truck through 4 1/2 inch drill pipe.

RECEIVED  
STATE CORPORATION COMMISSION

(If additional description is necessary, use BACK of this sheet)

Name of Plugging Contractor Halliburton Services  
410 Union Center Bldg. Wichita, Kansas 67202

SEP 15 1977

CONSERVATION DIVISION  
Wichita, Kansas  
SS.

STATE OF Kansas COUNTY OF Sedgwick

Dean Britting, agent

(~~XXXXXXXXXX~~ of owner) or (~~XXXXXXXXXX~~)

of the above-described well, being first duly sworn on oath, says: That I have knowledge of the facts, statements, and matters herein contained and the log of the above-described well as filed and that the same are true and correct. So help me God.

(Signature)


Dean Britting

200 No. Main Wichita, Kansas 67202  
(Address)

SUBSCRIBED AND SWORN TO before me this 13th day of September, 1977

Elsie Willison Elsie Willison  
Notary Public.

My commission expires June 30 1978

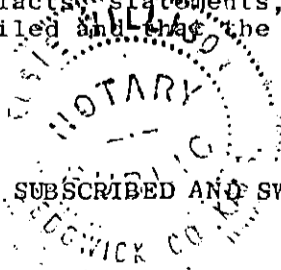

15-095-20622-000 0

KANSAS GEOLOGICAL SOCIETY  
KANSAS WELL LOG BUREAU - KANSAS WELL SAMPLE BUREAU  
KANSAS GEOLOGICAL SOCIETY BUILDING  
508 EAST MURDOCK - WICHITA, KANSAS

COMPANY **Halliburton Oil Producing Company**

SEC. 21 T. 30S R. 6W

FARM **Boileau** NO. 1

LOC. NE SE

TOTAL DEPTH **4,535'**

COUNTY **Kingman**


COMM. **August 26, 1977**

COMP. **September 9, 1977**

SHOT OR TREATED

CONTRACTOR **H-30, Inc.**

ISSUED **September 13, 1977**

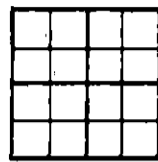

CASING

20	10		
15	8 5/8"	283' cemented w/250 sxs cement	ELEVATION 1402 K.B.
12	6		
13	5		

FIGURES INDICATE BOTTOM OF FORMATIONS

Red Bed	450'
Shale	1,070'
Shale and Lime	1,395'
Lime and Shale	3,900'
Lime	4,194'
Chert and Lime	4,340'
Lime	4,448'
Shale	4,498'
Lime and Shale	4,535'
Rotary Total Depth	4,535'


I hereby certify the above and foregoing to be a true and correct log of the above described well as shown by the drilling reports.

H-30, Inc.

*Dean Britting*  
Dean Britting

State of Kansas }  
County of Sedgwick } ss:

Subscribed and Sworn to before me a Notary Public in and for said county and state this 13<sup>th</sup> day of September, 1977

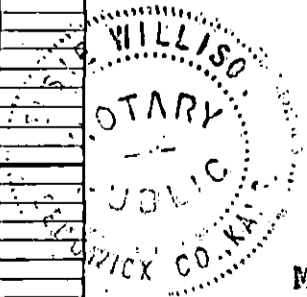

*Elsie Willison*  
Elsie Willison - Notary Public

My Commission Expires:  
June 30, 1978

RECEIVED  
STATE CORPORATION COMMISSION

SEP 15 1977

CONSERVATION DIVISION  
Wichita, Kansas