

STATE OF KANSAS
STATE CORPORATION COMMISSION

Form CP-4

Give All Information Completely
Make Required Affidavit
Mail or Deliver Report to:
Conservation Division
State Corporation Commission
212 No. Market
Wichita, Kansas 67202

WELL PLUGGING RECORD

Kingman County, Sec. 20, Twp. 30s, Rge. 6 (E) W (W)
Location as "NE/CNWxSW" or footage from lines C NE 7/8 NW 4

Lease Owner Eli Wilkonson

Lease Name Huey Heirs Well No. 1

Office Address 415 Philtower Bldg. Tulsa, Oklahoma

Character of Well (completed as Oil, Gas or Dry Hole) oil well

Date well completed no comp. date 19__

Application for plugging filed 7-6-70 19__

Application for plugging approved 7-9-70 19__


Plugging commenced 7-23-70 19__

Plugging completed 7-28-70 19__

Reason for abandonment of well or producing formation depleted

If a producing well is abandoned, date of last production 19__

Was permission obtained from the Conservation Division or its agents before plugging was commenced? yes

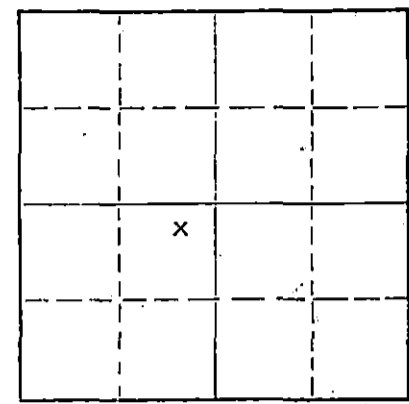

Locate well correctly on above Section Plat

Name of Conservation Agent who supervised plugging of this well G.R. Barbstine

Producing formation _____ Depth to top _____ Bottom _____ Total Depth of Well 4184 Feet

Show depth and thickness of all water, oil and gas formations.

OIL, GAS OR WATER RECORDS

CASING RECORD

FORMATION	CONTENT	FROM	TO	SIZE	PUT IN	PULLED OUT
				8 5/8	248'	none
				4 1/2	4222'	3128.50'

Describe in detail the manner in which the well was plugged, indicating where the mud fluid was placed and the method or methods used in introducing it into the hole. If cement or other plugs were used, state the character of same and depth placed, from _____ feet to _____ feet for each plug set.

Fill bottom from 4184' to 4100' with gravel, mix and dump 3 sacks cement.

Set 10' rock bridge from 240' to 230', dump 4 yards ready mix to surface.

RECEIVED
STATE CORPORATION COMMISSION
AUG 14 1970
CONSERVATION DIVISION
Wichita, Kansas

(If additional description is necessary, use BACK of this sheet)

Name of Plugging Contractor Flint Engineering and Const. Co.


Address 2375 W. Central El Dorado, Kansas

STATE OF Kansas, COUNTY OF Butler, ss.

_____, (employee of owner) or (owner or operator) of the above-described well, being first duly sworn on oath, says: That I have knowledge of the facts, statements, and matters herein contained and the log of the above-described well as filed and that the same are true and correct. So help me God.

(Signature) Richard C. Hausman

Subscribed and sworn to before me this 12 day of August, 19 70

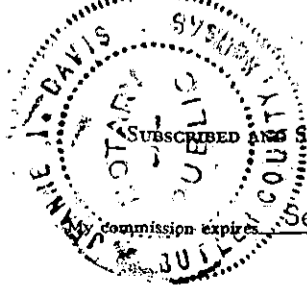

James L. Davis
Notary Public.