


STATE OF KANSAS STATE CORPORATION COMMISSION

Give All Information Completely Make Required Affidavit Mail or Deliver Report to: Conservation Division State Corporation Commission 212 No. Market Wichita, Kansas

WELL PLUGGING RECORD

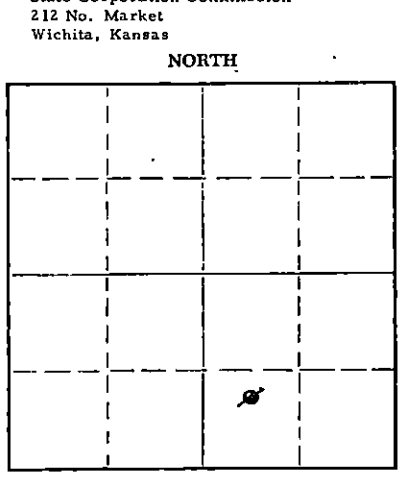

Locate well correctly on above Section Plat

Kingman County. Sec. 19 Twp. 30 Rge. 6W (R) (W) Location as "NE/CNW%SW%" or footage from lines G N/2 SW SE Lease Owner: Clinton Oil Company Lease Name: Reida Well No. 3X Office Address: Wichita, Kansas Character of Well (completed as Oil, Gas or Dry Hole) Oil Date well completed November 29 19 65 Application for plugging filed September 5 19 67 Application for plugging approved September 5 19 67 Plugging commenced 9/21/67 19 Plugging completed 9/25/67 19 Reason for abandonment of well or producing formation depleted.

If a producing well is abandoned, date of last production September 11 19 67 Was permission obtained from the Conservation Division or its agents before plugging was commenced? yes

Name of Conservation Agent who supervised plugging of this well Elving Producing formation Mississippi Depth to top 4172' Bottom 4176' Total Depth of Well 4241 Feet Show depth and thickness of all water, oil and gas formations.

OIL, GAS OR WATER RECORDS

CASING RECORD

Table with 7 columns: FORMATION, CONTENT, FROM, TO, SIZE, PUT IN, PULLED OUT. Row 1: 8-5/8", 266', none. Row 2: 5-1/2", 4240', 3678'.

Describe in detail the manner in which the well was plugged, indicating where the mud fluid was placed and the method or methods used in introducing it into the hole. If cement or other plugs were used, state the character of same and depth placed, from feet to feet for each plug set.

Checked hole, sanded back to 4225' and ran 5 sacks of cement. Checked hole, shot pipe at 3723' and 3657', worked pipe loose. Pulled 5 1/2" casing. Set 10' rock bridge at 260' and ran 25 sacks of cement. Mudded hole to 40', 10' rock bridge and ran 10 sacks of cement. Talled pipe.


PLUGGING COMPLETE.

STATE CORPORATION COMMISSION OCT 5 1967 CONSERVATION DIVISION Wichita, Kansas

(If additional description is necessary, use BACK of this sheet) Name of Plugging Contractor KNIGHT CASING PULLING COMPANY Address CHASE, KANSAS

STATE OF KANSAS COUNTY OF RICE, ss. NOEL J. KNIGHT (employee of owner) or (owner or operator) of the above-described well, being first duly sworn on oath, says: That I have knowledge of the facts, statements, and matters herein contained and the log of the above-described well as filed and that the same are true and correct. So help me God.

(Signature) Noel Knight CHASE, KANSAS (Address)

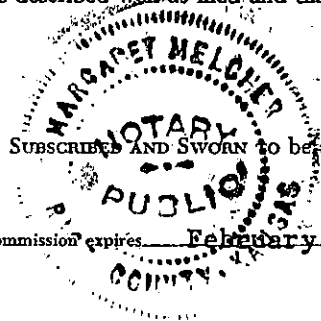

Subscribed and sworn to before me this 28th day of September, 19 67. My commission expires February 15, 1971. Margaret Melcher Notary Public.

WELL LOG

15-095-30065-0000

COMPANY Clinton Oil Company

SEC. 19 T. 30S R. 6W

FARM Reid

NO. 3-X

LOC. C N/2 SW SE

TOTAL DEPTH 4241'

COUNTY Kingman

COMM. 11-2-65

COMP. 11-12-65

CONTRACTOR Garvey Drilling Company



CASING 8 5/8" @ 266' w/200 sx

5 1/2" @ 4240' w/100 sx

ELEVATION 1475' DF

PRODUCTION

FIGURES INDICATE BOTTOM OF FORMATIONS

- 60' Red Bed
- 810' Red Bed and Shale
- 1030' Shale
- 1483' Lime and Shale
- 1706' Shale and Lime
- 1930' Lime and Shale
- 2270' Shale with Lime Streaks
- 3045' Shale and Lime
- 3375' Lime and Shale
- 3437' Lime
- 3555' Lime and Shale
- 3855' Lime
- 4065' Lime and Shale
- 4110' Lime
- 4165' Shale and Lime
- 4177' Lime and Chert Mississippi
- 4241' Lime and Chert
- 4241' RTD

RECEIVED  
STATE CORPORATION COMMISSION

SEP 5 1967

CONSERVATION DIVISION  
Wichita, Kansas

State of Kansas

County of Barton

I, Sam N. Stephens of Garvey Drilling Company

upon oath state the above and foregoing is a true and correct copy of the log of the Reida 3-X well.

Subscribed and sworn to before me this 17th day of November 19 65

My Commission Expires: November 5, 1969

NOTARY PUBLIC