

15-095-01302-0000

STATE OF KANSAS
STATE CORPORATION COMMISSION

Give All Information Completely
Make Required Affidavit
Mail or Deliver Report to:
Conservation Division
State Corporation Commission
211 No. Broadway
Wichita, Kansas

WELL PLUGGING RECORD

Kingman County, Sec. 19 Twp. 30S Rge. 6 (E) W (W)

Location as "NE/CNW/SW" or footage from lines C SW SW NE

Lease Owner Simclair Oil & Gas Company

Lease Name Cecilia Kalivoda Well No. 1

Office Address P. O. Box 521, Tulsa, Oklahoma

Character of Well (completed as Oil, Gas or Dry Hole) Dry Hole

Date well completed 8-6 19 57

Application for plugging filed 8-5- 19 57

Application for plugging approved 8-8 19 57

Plugging commenced 8-8 19 57

Plugging completed 8-14 19 57

Reason for abandonment of well or producing formation Dry Hole

If a producing well is abandoned, date of last production - 19 -

Was permission obtained from the Conservation Division or its agents before plugging was commenced? Yes

Name of Conservation Agent who supervised plugging of this well M. A. Rives

Producing formation None Depth to top - Bottom - Total Depth of Well 4250 Feet

Show depth and thickness of all water, oil and gas formations.

OIL, GAS OR WATER RECORDS

CASING RECORD

FORMATION	CONTENT	FROM	TO	SIZE	PUT IN	PULLED OUT
None - Dry Hole				10-3/4	280'	None
				5-1/2	4250'	3059'

Describe in detail the manner in which the well was plugged, indicating where the mud fluid was placed and the method or methods used in introducing it into the hole. If cement or other plugs were used, state the character of same and depth placed, from - feet to - feet for each plug set.

Set Halliburton squeeze packer and attempted to set at 4117'
Packer failed to set. Pushed packer to bottom and ran another packer and set at 4113'. Squeezed Mississippi perms. 4131-37' with 200 sacks posmix cement. Displaced 170 sacks into formation, 7 sacks in casing and washed back 23 sacks.
Moved in casing pulling machine and checked hole. Found cement at 4064'. Pulled 3059' of 5 1/2" OD casing. Circulated casing with rotary mud. Bailed fluid down to 275', set a 10' rock bridge 275' to 265'. Dumped 25 sacks cement from 265' to 230'. Filled hole with mud from 230' to 30'. Set rock bridge from 30' to 20'. Dumped 10 sacks cement from 20' to Surface.

(If additional description is necessary, use BACK of this sheet)

Name of Plugging Contractor West Supply Co., Inc.
Address Chase, Kansas

STATE OF Kansas, COUNTY OF Rice, ss.

W. B. Rhees (employee of owner) or (~~agent or operator~~) of the above-described well, being first duly sworn on oath, says: That I have knowledge of the facts, statements, and matters herein contained and the log of the above-described well as filed and that the same are true and correct. So help me God.


(Signature) W. B. Rhees
P. O. Box 551, Chase, Kansas
(Address)

SUBSCRIBED AND SWORN to before me this 27th day of August, 19 57

My commission expires 21 Oct. 1959

William C. Has Notary Public.
RECEIVED
STATE CORPORATION COMMISSION
8-28-57 AUG 28 1957
CONSERVATION DIVISION
Wichita, Kansas

PLUGGING
FILE SEC. 19 T. 30 R. 6W
BOOK PAGE 33 LINE 16

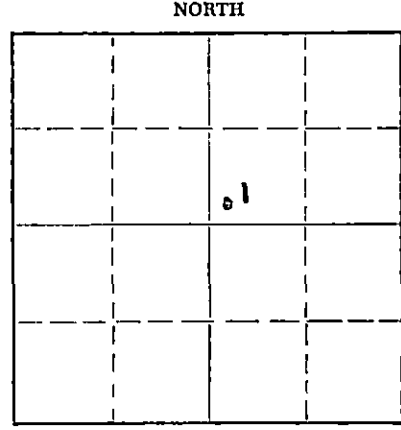

Locate well correctly on above Section Plat

CECILIA KALIVODA NO. 1
 NE/4 Section 19-30S-6W
 Kingman County, Kansas
 Sinclair Oil & Gas Company

10-3/4" O. D. casing cemented at 282'
 5-1/2" O. D. casing cemented at 4250'

Drilling commenced 7-13-57
 Drilling completed 7-28-57

FROM	TO	FORMATION	REMARKS
0'	175'	Red rock, sand & shells	
175	285	Red bed, sand & shale	10-3/4" O. D. casing cemented at 282'
285	500	Red bed	
500	1025	Grey shale & shells	
1025	1100	Lime & shale	
1100	1310	Lime with shale streaks	
1310	1460	Shale & lime	
1460	1733	Lime	
1733	1834	Lime & shale	
1834	2040	Shale & lime	
2040	2329	Lime & shale	
2329	2755	Shale & lime	
2755	2926	Shale	
2926	2939	Lime	
2939	3020	Shale & lime	
3020	3127	Lime & shale	
3127	3220	Sandy shale & lime	
3220	3286	Shale & lime	
3286	3407	Lime & shale	
3407	3500	Lime	
3500	3656	Shale & lime	
3656	3850	Lime	
3850	4108	Lime & shale	
4108	4155	Lime	
4155	4190	Mississippi lime	
4190	4214	Mississippi lime (chat)	
4214	4250	Mississippi lime & chert	5-1/2" O. D. casing cemented at 4250'
T. D.	4250'		

E. W. E. U.
 NATION COMMISSION
 AUG 10 1957
 CONSERVATION DIVISION
 Wichita, Kansas

This is a true copy of the driller's log as shown on the drilling tickets.

BARBOUR DRILLING COMPANY

BY: *E. W. Piibel*

Subscribed and sworn to before me on this 7th day of August, 1957.

Merry Jane Burt

Notary Public

My commission expires July 27, 1961.

PLUGGING	
FILE SEC. 19	T. 30 R. 6W.
BOOK PAGE 33	LINE 16