

STATE OF KANSAS  
STATE CORPORATION COMMISSION


Give All Information Completely  
Make Required Affidavit  
Mail or Deliver Report to:  
Conservation Division  
State Corporation Commission  
211 No. Broadway  
Wichita, Kansas

WELL PLUGGING RECORD

Kingman County. Sec. 19 Twp. 30 Rge. 6 (X) W (W)

Location as "NE/CNW%SW%" or footage from lines SW SW SW  
Lease Owner Petroleum, Inc.  
Lease Name Stevens "E" Well No. 1  
Office Address Route 2, Great Bend, Kansas  
Character of Well (completed as Oil, Gas or Dry Hole) Dry hole  
Date well completed September 2 1958  
Application for plugging filed September 2 1958  
Application for plugging approved September 2 1958  
Plugging commenced September 2 1958  
Plugging completed September 2 1958  
Reason for abandonment of well or producing formation No producible zones

NORTH

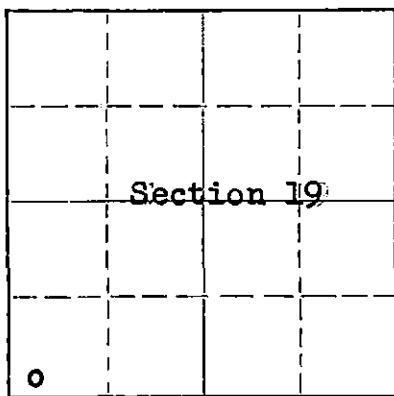

Locate well correctly on above Section Plat

If a producing well is abandoned, date of last production none 19  
Was permission obtained from the Conservation Division or its agents before plugging was commenced? yes

Name of Conservation Agent who supervised plugging of this well Fred Hampel  
Producing formation ----- Depth to top ----- Bottom ----- Total Depth of Well 4282 Feet  
Show depth and thickness of all water, oil and gas formations.

OIL, GAS OR WATER RECORDS

CASING RECORD

FORMATION	CONTENT	FROM	TO	SIZE	PUT IN	PULLED OUT
				8 5/8"	258'	None

Describe in detail the manner in which the well was plugged, indicating where the mud fluid was placed and the method or methods used in introducing it into the hole. If cement or other plugs were used, state the character of same and depth placed, from \_\_\_\_\_ feet to \_\_\_\_\_ feet for each plug set.

Mud up with heavy mud to 240' followed by a wooden plug and 1/3 sack hulls. Placed 20 sacks cement through drill pipe on top of plug. Mud up to 40' followed by a wooden plug and 1/3 sack hulls. Filled hole to base of well cellar with 10 sacks cement.

RECEIVED  
STATE CORPORATION COMMISSION  
SEP 19 1958  
CONSERVATION DIVISION

(If additional description is necessary, use BACK of this sheet)  
Name of Plugging Contractor Garvey Drilling Co.  
Address Route 2, Great Bend, Kansas

STATE OF Kansas COUNTY OF Barton, ss.  
Don Searle (employee of owner) or (owner) of the above-described well, being first duly sworn on oath, says: That I have knowledge of the facts, statements and matters herein contained and the log of the above-described well as filed and that the same are true and correct. So help me God.

(Signature) Don Searle  
Route 2, Great Bend, Kansas (Address)

SUBSCRIBED AND SWORN TO before me this 18th day of September 1958  
Notary Public.

My commission expires July 11, 1960

PLUGGING  
FILE SEC 19 T 30 R 6 W  
BOOK PAGE 127 LINE 29

# WELL LOG

COMPANY PETROLEUM, INCORPORATED

SEC. 19 T. 30S R. 6W

FARM STEVENS "E" NO. 1


LOC. SW, SW, SW

TOTAL DEPTH 4282'

COUNTY KINGMAN CO., KANSAS

COMM. August 22, 1958 COMP. September 2, 1958

CONTRACTOR GARVEY DRILLING COMPANY

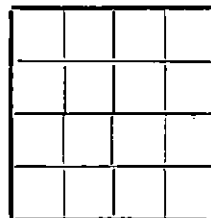

CASING 8 5/8" @ 258.16' W/175 sax.

ELEVATION 1519' DF

PRODUCTION D & A

FIGURES INDICATE BOTTOM OF FORMATIONS

235	Red rock & shale
260	Shale
1100	Shale & shells
1200	Shale & lime
1330	Lime & shale
1590	Lime
1680	Lime & shale
1700	Shale & lime
1765	Shale
1930	Shale & lime
2155	Shale
2520	Shale & lime
2775'	Shale
3200	Lime & shale
3336	Lime, shale & sand
3448	Lime & shale
3573	Lime
3684	Lime & shale
3919	Lime
4094	Lime & shale
4161	Shale & lime
4220	Shale & chert
4282	Chert
4282	T. D.

**RECEIVED**  
 STATE CORPORATION COMMISSION  
 SEP 19 1958  
 CONSERVATION DIVISION  
 Wichita, Kansas

State of KANSAS )  
 County of BARTON ) ss:

**PLUGGING**  
 FILE SEC. 19 T. 30 R. 6W  
 BOOK PAGE 127 LINE 29

I, VERNE A. MORRIS of GARVEY DRILLING COMPANY.

upon oath state that the above and foregoing is a true and correct copy of the log of the #1 STEVENS "E" well

Subscribed and sworn to before me this 17th day of September 19 58

My Commission Expires: July 11, 1960

*Verne A. Morris*  
 \_\_\_\_\_  
*John T. Brown*  
 \_\_\_\_\_  
 NOTARY PUBLIC