


WELL PLUGGING RECORD

Information Completely
Make Required Affidavit
Mail or Deliver Report to:
Conservation Division
State Corporation Commission
800 Bitting Building
Wichita, Kansas

Sumner County. Sec. 33 Twp. 34S Rge. 3W (E) (W)

Location as "NE/CNW $\frac{1}{4}$ /SW $\frac{1}{4}$ " or footage from lines SE NW NW
Lease Owner The Texas Company
Lease Name M. E. Kloefkorn Well No. 1
Office Address 614 Bitting Building, Wichita, Kansas
Character of Well (completed as Oil, Gas or Dry Hole) Dry
Date well completed March 18 19 52
Application for plugging filed (Verbal 3-18) March 19 19 52
Application for plugging approved " " " March 20 19 52
Plugging commenced March 19 19 52
Plugging completed March 19 19 52
Reason for abandonment of well or producing formation

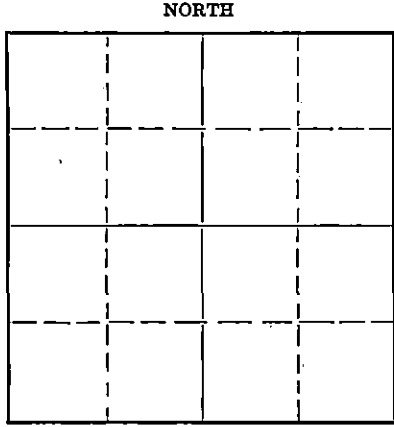

Locate well correctly on above
Section Flat

If a producing well is abandoned, date of last production 19
Was permission obtained from the Conservation Division or its agents before plugging was commenced? Yes

Name of Conservation Agent who supervised plugging of this well Mr. W. G. Buffington
Producing formation Depth to top Bottom Total Depth of Well 4821 Feet
Show depth and thickness of all water, oil and gas formations.

OIL, GAS OR WATER RECORDS

CASING RECORD

Formation	Content	From	To	Size	Put In	Pulled Out
				10-3/4"	588'	0'

Describe in detail the manner in which the well was plugged, indicating where the mud fluid was placed and the method or methods used in introducing it into the hole. If cement or other plugs were used, state the character of same and depth placed, from feet to feet for each plug set.

PLUGGED AS FOLLOWS:

4821-588	Heavy Mud
588	Wooden Plug
588-535	25 Sacks Cement
535-15	Heavy Mud
15-0	15 Sacks Cement

(If additional description is necessary, use BACK of this sheet)

Name of Plugging Contractor Stickle Drilling Company
Address Bitting Building, Wichita, Kansas

STATE OF Kansas, COUNTY OF Sedgwick, ss.
M. C. Harrell (employee of owner) or (owner or operator) of the above-described well,
being first duly sworn on oath, says: That I have knowledge of the facts, statements, and matters herein contained and the log of the above-described well as filed and that the same are true and correct. So help me God.

(Signature) M. C. Harrell
614 Bitting Bldg., Wichita, Kansas (Address)

SUBSCRIBED AND SWORN to before me this 26th day of March 19 52
Howard Kestler Notary Public.

My commission expires September 20, 1952

23-8390-5 8-31-20M

PLUGGING

FILE SEC 33 T3P R 3W

BOOK PAGE 2 LINE 40

MAR 28 1952 3-28-52

15-191-00530-0000

STATE OF KANSAS
STATE CORPORATION COMMISSION

All Information Completely
as Required Affidavit
Mall or Deliver Report to:
Conservation Division
State Corporation Commission
800 Bitting Building
Wichita, Kansas

WELL PLUGGING RECORD

Summer

County, Sec. 33 Twp. 34S Rge. 3W (E) (W)

Location as "NE/CNW¹/₄SW¹/₄" or footage from lines SE NW NW

Lease Owner The Texas Company

Lease Name M. E. Kloefkorn Well No. 1

Office Address 614 Bitting Building, Wichita, Kansas

Character of Well (completed as Oil, Gas or Dry Hole) Dry

Date well completed March 18 19 52

Application for plugging filed (Verbal 3-18) March 19 19 52

Application for plugging approved " " " March 20 19 52

Plugging commenced March 19 19 52

Plugging completed March 19 19 52

Reason for abandonment of well or producing formation

If a producing well is abandoned, date of last production 19

Was permission obtained from the Conservation Division or its agents before plugging was commenced? Yes

Name of Conservation Agent who supervised plugging of this well Mr. W. G. Buffington

Producing formation Depth to top Bottom Total Depth of Well 4821 Feet

Show depth and thickness of all water, oil and gas formations.

OIL, GAS OR WATER RECORDS

CASING RECORD

Formation	Content	From	To	Size	Put In	Pulled Out
				10-3/4"	588'	0'

Describe in detail the manner in which the well was plugged, indicating where the mud fluid was placed and the method or methods used in introducing it into the hole. If cement or other plugs were used, state the character of same and depth placed, from feet to feet for each plug set.

PLUGGED AS FOLLOWS:

4821-588	Heavy Mud
588	Wooden Plug
588-535	25 Sacks Cement
535-15	Heavy Mud
15-0	15 Sacks Cement

(If additional description is necessary, use BACK of this sheet)

Name of Plugging Contractor Stickle Drilling Company

Address Bitting Building, Wichita, Kansas

STATE OF Kansas, COUNTY OF Sedgwick, ss.
M. C. Harrell (employee of owner) or (owner or operator) of the above-described well,

being first duly sworn on oath, says: That I have knowledge of the facts, statements, and matters herein contained and the log of the above-described well as filed and that the same are true and correct. So help me God.


(Signature) M. C. Harrell

614 Bitting Bldg., Wichita, Kansas (Address)

SUBSCRIBED AND SWORN TO before me this 26th day of March, 19 52

H. Howard Kestler Notary Public.

My commission expires September 20, 1952

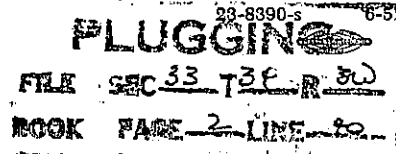

MAR 28 1952

LOG OF WELL

SHEET No. 2

District Kansas Owner The Texas Co. Farm No. Blockhorn Well No. 1

FORMATION	AMOUNT	COLOR	HARD OR SOFT	DEPTH CORES TAKEN	REMARKS
Sandy Red Bed & Shale	310				<u>CASING RECORD:</u> 10-3/4" casing set at 588' with 450 sacks cement. <u>SILVATIME:</u> DF-1151 KB-1154 M-1144 <u>LOGS:</u> Stalnaker ----- 3160 Layton ----- 3577 Kansas City --- 3652 Mississippian - 4337 Kinderhook ---- 4658 Cherokee ----- 4729 Viola ----- 4768 Simpson ----- 4783 Simpson Sand -- 4790
Shale & Shells	480	170			
Shale, Salt & Shells	590	110			
Shale & Anhydrite	675	85			
Lime & Shale	850	175			
Shale & Lime	1020	170			
Sandy Lime & Shale	1200	180			
Lime & Shale	1645	445			
Shale & Lime	2390	745			
Lime & Shale	2400	70			
Shale & Lime	2598	136			
Lime & Shale	2810	212			
Shale & Lime	2864	54			
Lime & Shale	3025	161			
Shale & Lime	3190	165			
Shale & Sand	3243	53			
Sand & Shale	3355	112			
Shale & Sand	3393	38			
Shale & Lime	3543	150			
Shale	3575	32			
Sand	3597	22			
Sand, Shale & Lime	3659	62			
Lime	3690	31			
Lime Broken	3724	34			
Lime	3728	4			
Shale Sand & Lime	3780	52			
Sand & Shale	3825	45			
Lime	3848	23			
Lime & Shale	3888	40			
Shale & Lime	3940	52			
Lime	3953	13			
Lime & Shale	3978	25			
Lime	4001	23			
Lime & Shale	4022	21			
Shale & Lime	4057	35			
Lime & Shale	4095	38			
Shale & Lime	4350	255			
Chert & Lime	4360	10			
Lime & Chert	4395	35			
Lime	4666	271			
Lime & Shale	4678	12			
Lime	4713	35			
Shale, Chalky Lime	4739	26			
Shale & Lime	4765	26			
Coring	4821	56			
Total Depth	4821				

LOG OF WELL

SHEET NO. 3

District Kansas Owner The Texas Co. Farm H.E. Kloefkorn Well No. 1

FORMATION	AMOUNT	COLOR	HARD OR SOFT	DEPTH CORES TAKEN	REMARKS
<u>REMARKS:</u>					
3-4-52	Ran DST #1	from 4337-50,	open 1 hour,	recovered 450'	gas and 150' gas cut muddy saltwater with rainbow of oil. SBHP 390' in 15 minutes.
3-5-52	Ran DST #2	from 4390-4400,	open 1 hour,	recovered 135'	muddy, gassy saltwater and 180' saltwater. SBHP 1695' in 15 minutes.
3-15-52	Took core #1	from 4765-75,	recovered 9' 9".		
	Took core #2	from 4775-85,	recovered 9' 6".		
	Took core #3	from 4765-95,	recovered 10'.		
3-16-52	Took core #4	from 4795-4805,	recovered 10';		very slight show oil from 4803-05.
3-17-52	Took core #5	from 4805-4821,	recovered 16'.		
	Ran DST #3	from 4775-95,	open 1 hour,	recovered 60'	thin slightly gas cut mud. SBHP 1780' in 15 minutes.
3-18-52	Ran DST #4	from 4775-4821,	open 1 hour,	recovered 3780'	saltwater. SBHP 1870' in 15 minutes. Ran Schlumberger Survey.
3-19-52	Ran DST #5	from 4772-99,	open 1-1/2 hours,	recovered 120'	muddy saltwater, very slight show oil. SBHP 1785' in 15 minutes. Plugged and Abandoned.