


STATE OF KANSAS  
STATE CORPORATION COMMISSION

WELL PLUGGING RECORD

Give All Information Completely  
Make Required Affidavit  
Mail or Deliver Report to  
Conservation Division  
State Corporation Comm.  
245 North Water  
Wichita, KS 67202

Morton County, Sec. 13 Twp. 33S Rge. 43  $\frac{1}{4}$ W  
Location as "NE/CNW $\frac{1}{4}$ SW $\frac{1}{4}$ " or footage from lines  
810' FNL - 660' FEL - NE/4  
Lease Owner Cities Service Company  
Lease Name Collingwood C Well No. 4  
Office Address 3545 N.W. 58th - Oklahoma City, OK 73112  
Character of Well (Completed as Oil, Gas or Dry Hole)  
Dry Hole

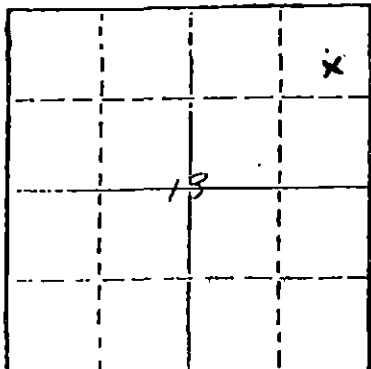

Locate well correctly on above  
Section Plat

Date Well completed 6-5 1982  
Application for plugging filed 19  
Application for plugging approved 19  
Plugging commenced 6-4 1982  
Plugging completed 6-5- 1982  
Reason for abandonment of well or producing formation  
Dry Hole

If a producing well is abandoned, date of last production  
19

Was permission obtained from the Conservation Division or  
its agents before plugging was commenced? Yes

Name of Conservation Agent who supervised plugging of this well Clarence Thomas  
Producing formation None Depth to top Bottom Total Depth of Well 4750'  
Show depth and thickness of all water, oil and gas formations.

OIL, GAS OR WATER RECORDS

CASING RECORD

FORMATION	CONTENT	FROM	TO	SIZE	PUT IN	PULLED OUT
NONE				8-5/8"	1354	None

Describe in detail the manner in which the well was plugged, indicating where the mud fluid  
was placed and the method or methods used in introducing it into the hold. If cement or other  
plugs were used, state the character of same and depth placed, from feet to  
feet for each plug set.

Set plugs w/class H cmt as follows: 35 sx 4600-4700'; 55 sx 3620-3770; 50 sx 1400-1240';  
bottom surface pipe 1354'; 25 sx 680-600; 10 sx 0-40' w/wooden plug on bottom; 10 sx rathole.

RECEIVED  
STATE CORPORATION COMMISSION  
6-17-82  
JUN 17 1982

CONSERVATION DIVISION  
Wichita Kansas

(If additional description is necessary, use BACK of this sheet)

Name of Plugging Contractor Dowell

STATE OF Oklahoma COUNTY OF Oklahoma, ss.  
Verlin Meier (employee of owner) or (owner or operator)

of the above-described well, being first duly sworn on oath, says: That I have knowledge of  
the facts, statements, and matters herein contained and the log of the above-described well  
as filed and that the same are true and correct. So help me God.

(Signature) Verlin Meier Production Region Mgr  
3545 N.W. 58th - Okla. City, OK 73112  
(Address)

SUBSCRIBED AND SWORN TO before me this 16th day of June, 1982

My commission expires July 11 1984

(Signature) Notary Public.

