

DEC 6 1979


STATE OF KANSAS
STATE CORPORATION COMMISSION

WELL PLUGGING RECORD

Give All Information Completely
Make Required Affidavit
Mail or Deliver Report to
Conservation Division
State Corporation Comm.
245 North Water
Wichita, KS 67202

Kingman County, Sec. 3 Twp. 29S Rge. 9W /E/W
Location as "NE/CNW $\frac{1}{2}$ SW $\frac{1}{2}$ " or footage from lines
C NE/4 NE/4 SE/4

Lease Owner Gear Petroleum Co., Inc.
Lease Name Gillen Well No. 1
Office Address 300 Sutton Place, Wichita, Kansas 67202
Character of Well (Completed as Oil, Gas or Dry Hole)
D & A

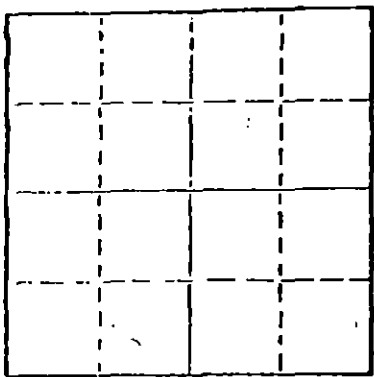

Locate well correctly on above
Section Plat

Date Well completed December 3, 1979
Application for plugging filed December 3, 1979
Application for plugging approved December 3, 1979
Plugging commenced December 3, 1979
Plugging completed December 3, 1979
Reason for abandonment of well or producing formation
D & A

If a producing well is abandoned, date of last production
19

Was permission obtained from the Conservation Division or
its agents before plugging was commenced? Yes

Name of Conservation Agent who supervised plugging of this well Wm. T. Owen
Producing formation Depth to top Bottom Total Depth of Well 4,583
Show depth and thickness of all water, oil and gas formations.

OIL, GAS OR WATER RECORDS CASING RECORD

FORMATION	CONTENT	FROM	TO	SIZE	PUT IN	PULLED OUT
				8 5/8"	220.31'	-0-

Describe in detail the manner in which the well was plugged, indicating where the mud fluid
was placed and the method or methods used in introducing it into the hold. If cement or other
plugs were used, state the character of same and depth placed, from feet to
feet for each plug set.

Plugged @ 240' w/40 sx cement
@ 40' w/10 sx cement
5 sx cement in rathole

(If additional description is necessary, use BACK of this sheet)
Name of Plugging Contractor Red Tiger Drilling Company
1720 KSB&T Building, Wichita, Kansas 67202

RECEIVED
STATE CORPORATION COMMISSION
DEC 7 1979

STATE OF Kansas COUNTY OF Sedgwick CONSERVATION DIVISION contractor
Gloria Fawcett (employee of xxxxxxxxx)


of the above-described well, being first duly sworn on oath, says: That I have knowledge of
the facts, statements, and matters herein contained and the log of the above-described well
as filed and that the same are true and correct. So help me God.

(Signature) Gloria Fawcett
1720 KSB&T Building, Wichita, Kansas 67202
(Address)

SUBSCRIBED AND SWORN TO before me this 5th day of December, 1979.

Joyce A. Hagermann
Notary Public.

My commission expires

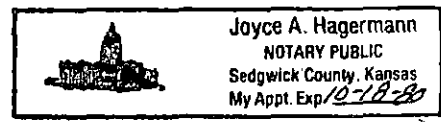

DEC 6 1979

DRILLERS LOG

No. 1 Gillen

CASING RECORD:	COMPANY	Gear Petroleum Co., Inc.	DESCRIPTION:
8 5/8" @ 230' w/200 sx cement	CONTRACTOR:	Red Tiger Drilling Company	C NE/4 NE4/ SE/4 Sec. 3-T29S-R9W Kingman County, Kansas
	COMMENCED:	November 21, 1979	
	COMPLETED:	December 3, 1979	
TOTAL DEPTH: 4,583'			ELEVATION: 1,710 GL

<u>FORMATION</u>	<u>FROM</u>	<u>TO</u>	<u>REMARKS</u>
Sand	0	80	
Red Bed & Shale	80	826	
Shale	826	1365	
Shale & Lime	1365	1567	
Lime & Shale	1567	4583	
RTD		4583	


I certify that this is a true and correct copy of the above log to the best of my knowledge.

RED TIGER DRILLING COMPANY

Gloria Fawcett
Gloria Fawcett

Subscribed and sworn to before me this 5th day of December, 1979.

Joyce A. Hagermann
Notary Public

	Joyce A. Hagermann NOTARY PUBLIC Sedgwick County, Kansas My Appt. Exp 10-18-80
---	---

RECEIVED
STATE CORPORATION COMMISSION
DEC - 7 1979
CONSERVATION DIVISION
Wichita, Kansas