


STATE OF KANSAS
STATE CORPORATION COMMISSION
CONSERVATION DIVISION
P. O. BOX 17027
WICHITA, KANSAS 67217

FORM CP-4

WELL PLUGGING RECORD

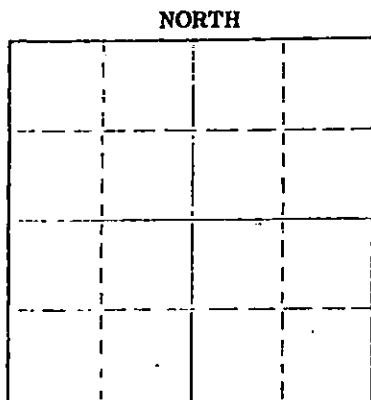

Locate well correctly on above Section Plat

Kingman County, Sec. 2 Twp. 29S Rge. 9W (XX) (XX)
Location as "NE/CNW/SW" or footage from lines SW SW SW
Lease Owner Little George Oil Company
Lease Name Julia Govert Well No. 1
Office Address 225 Sutton Place, Wichita, Kansas 67202
Character of Well (completed as Oil, Gas or Dry Hole) Dry Hole
Date well completed July 28, 19 74
Application for plugging filed Verbal Application 19
Application for plugging approved Verbal Approval 19
Plugging commenced July 28, 19 74
Plugging completed July 28, 19 74
Reason for abandonment of well or producing formation

If a producing well is abandoned, date of last production 19
Was permission obtained from the Conservation Division or its agents before plugging was commenced? Yes

Name of Conservation Agent who supervised plugging of this well J. R. Biberstein
Producing formation Depth to top Bottom Total Depth of Well 4,588 feet
Show depth and thickness of all water, oil and gas formations.

OIL, GAS OR WATER RECORDS

CASING RECORD

FORMATION	CONTENT	FROM	TO	SIZE	PUT IN	PULLED OUT
				8-5/8"	244'	None

RECEIVED
STATE CORPORATION COMMISSION
AUG 1 1974
CONSERVATION DIVISION
Wichita, Kansas

Describe in detail the manner in which the well was plugged, indicating where the mud fluid was placed and the method or methods used in introducing it into the hole. If cement or other plugs were used, state the character of same and depth placed, from feet to feet for each plug set.

Filled hole with heavy rotary mud from 4,588 feet (rotary total depth) to 240 feet. Set plug at 240 feet and cemented with 25 sacks cement. Filled hole with heavy rotary mud from 240 feet to 40 feet. Set solid plug at 40 feet and cemented to cellar with 10 sacks cement, two sacks cement in rat hole.

Plugging operations accomplished utilizing Allied Oil Well Cementing pump truck through 4 1/2 inch drill pipe.

(If additional description is necessary, use BACK of this sheet)
Name of Plugging Contractor H-30, Inc.
Address 200 North Main, Wichita, Kansas 67202

STATE OF Kansas COUNTY OF Sedgwick ss.
Dean Britting, Agent

(Signature of owner) (Name of contractor) of the above-described well, being first duly sworn on oath, says: That I have knowledge of the facts, statements, and matters herein contained and the log of the above-described well as filed and that the same are true and correct. So help me God.

(Signature) Dean Britting
200 North Main, Wichita, Kansas 67202
(Address)

Subscribed and sworn to before me this 31st day of July, 19 74

My commission expires 11-22-76

Mary M. Kittle
Notary Public.

Mary M. Kittle
NOTARY PUBLIC
Sedgwick County, Kansas

KANSAS GEOLOGICAL SOCIETY
KANSAS WELL LOG BUREAU - KANSAS WELL SAMPLE BUREAU
KANSAS GEOLOGICAL SOCIETY BUILDING
508 EAST MURDOCK - WICHITA, KANSAS

COMPANY Little George Oil Company

SEC. 2 T. 29S. 9W
LOC. SW SW SW


FARM Julia Govert NO. 1

COUNTY Kingman

TOTAL DEPTH 4,588'
COMM. July 15, 1974
SHOT OR TREATED
CONTRACTOR H-30, Inc.
ISSUED

COMP. July 28, 1974

KANSAS

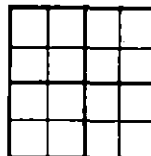

CASING

20 10
15 8 -5/8" 244' cemented w/200 sxs cement ELEVATION 1,720 KB
12 6
13 5

PRODUCTION

FIGURES INDICATE BOTTOM OF FORMATIONS

Sand 75'
Red Shale 215'
Shale and Shells 245'
Shale 700'
Shale and Shells 1,379'
Lime and Shale 4,220'
Lime and Chert 4,280'
Lime and Shale 4,349'
Shale and Lime 4,430'
Lime and Shale 4,488'
Shale 4,495'
Lime 4,531'
Chert, Lime and Sand 4,588'
Rotary Total Depth 4,588'

RECEIVED
STATE CORPORATION COMMISSION
AUG 1 1974
CONSERVATION DIVISION
Wichita, Kansas

I hereby certify the above and foregoing to be a true and correct log of the above described well as shown by the drilling reports.

H-30, INC.

Dean Britting
Dean Britting

State of Kansas }
County of Sedgwick } ss:

Subscribed and Sworn to before me a Notary Public in and for said county and state this 31st. day of July, 1974.

Mary M. Kittle
Notary Public

My Commission Expires:

11-22-76

Mary M. Kittle
NOTARY PUBLIC
Sedgwick County, Kansas