


WELL PLUGGING RECORD

Give All Information Completely
Make Required Affidavit
Mail or Deliver Report to:
Conservation Division
State Corporation Commission
212 North Market, Insurance Bldg.
Wichita, Kansas

KINGMAN County. Sec. 32 Twp. 28s Rge. 5w (#) (W)
Location as "NE/CNW%SW%" or footage from lines C NW NW
Lease Owner PETROLEUM, INC.
Lease Name CALHOUN Well No. 1
Office Address ROUTE 2, GREAT BEND, KANSAS
Character of Well (completed as Oil, Gas or Dry Hole) DRY HOLE
Date well completed 1/27 19 61
Application for plugging filed 1/27 19 61
Application for plugging approved 1/27 19 61
Plugging commenced 1/27 19 61
Plugging completed 1/27 19 61
Reason for abandonment of well or producing formation NO PRODUCIBLE FORMATION

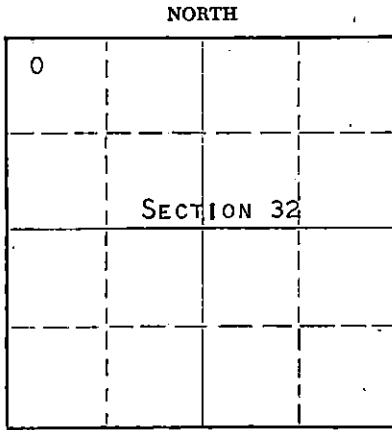

Locate well correctly on above Section Plat

If a producing well is abandoned, date of last production _____ 19____
Was permission obtained from the Conservation Division or its agents before plugging was commenced? YES

Name of Conservation Agent who supervised plugging of this well FRED HAMPEL
Producing formation _____ Depth to top _____ Bottom _____ Total Depth of Well 3935 Feet
Show depth and thickness of all water, oil and gas formations.

OIL, GAS OR WATER RECORDS

CASING RECORD

FORMATION	CONTENT	FROM	TO	SIZE	PUT IN	PULLED OUT
				8-5/8"	221'	NONE

Describe in detail the manner in which the well was plugged, indicating where the mud fluid was placed and the method or methods used in introducing it into the hole. If cement or other plugs were used, state the character of same and depth placed, from _____ feet to _____ feet for each plug set.

MUDDED UP WITH HEAVY MUD TO 210' FOLLOWED BY WOODEN PLUG AND 1/4 SACK OF HULLS.
PLACED 15 SACKS OF CEMENT ON TOP OF HULLS THROUGH DRILL PIPE. MUDDED UP WITH HEAVY MUD TO 40' FOLLOWED BY A WOODEN PLUG AND 1/4 SACK HULLS. PLACED 10 SACKS OF CEMENT TO BASE OF WELL CELLAR.

RECEIVED
STATE CORPORATION COMMISSION
FEB 24 1961
2-24-61
CONSERVATION DIVISION
Wichita, Kansas

(If additional description is necessary, use BACK of this sheet)
Name of Plugging Contractor GARVEY DRILLING COMPANY
Address ROUTE 2, GREAT BEND, KANSAS

STATE OF KANSAS, COUNTY OF BARTON, ss.
DON SEARLE (employee of owner) or (#####) of the above-described well, being first duly sworn on oath, says: That I have knowledge of the facts, statements, and matters herein contained and the log of the above-described well as filed and that the same are true and correct. So help me God.

(Signature) Don Searle
ROUTE 2, GREAT BEND, KANSAS
(Address)

SUBSCRIBED AND SWORN TO before me this 22ND day of FEBRUARY, 1961

My commission expires APRIL 14, 1963 Arthur J. Miles Notary Public.



WELL LOG

15-095-30270-0000

COMPANY **PETROLEUM, INCORPORATED**

SEC. 32 T-28S R. 5W

FARM **CALHOUN** NO. **1**


LOC. **C-NW, NW**

TOTAL DEPTH **3935'**

COUNTY **KINGMAN CO., KANSAS**

COMM. **January 17, 1961** COMP. **January 27, 1961**

CONTRACTOR **GARVEY DRILLING COMPANY**

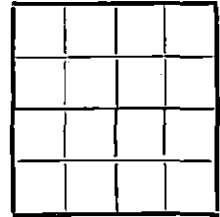

CASING **8 5/8" @ 221' w/150 sax.**

ELEVATION **1445' DF**

PRODUCTION **D & A**

FIGURES INDICATE BOTTOM OF FORMATIONS

400	Red bed & shale
770	Shale & shells
1165	Shale
1325	Shale & lime
1630	Lime & shale
1800	Shale & lime
2100	Shale
2330	Lime & shale
2590	Shale & lime
3057	Lime & shale
3170	Lime
3391	Lime & shale
3935	Lime
3935	T. D.

RECEIVED
 STATE CORPORATION COMMISSION
 FEB 24 1961
 CONSERVATION DIVISION
 Wichita, Kansas

State of KANSAS }
 County of BARTON } ss.

I, WERNE A. MORRIS of GARVEY DRILLING COMPANY

upon oath state that the above and foregoing is a true and correct copy of the log of the #1 CALHOUN well

Werne A. Morris

Subscribed and sworn to before me this 21st day of February 19 61

My Commission Expires: April 14, 1963

Arthur J. Wiles
 NOTARY PUBLIC