

15-095-20526-0000


STATE OF KANSAS
STATE CORPORATION COMMISSION

WELL PLUGGING RECORD

Give All Information Completely
Make Required Affidavit
Mail or Deliver Report to
Conservation Division
State Corporation Comm.
245 North Water
Wichita, KS 67202

Kingman County, Sec. 30 Twp. 28 Rge. 5W E/W
Location as "NE/CNW $\frac{1}{4}$ /SW $\frac{1}{4}$ " or footage from lines
NE NW NE

Lease Owner Maurice L. Brown
Lease Name Kastner A#1 Well No. _____
Office Address Wichita, Kansas 67202
Character of Well (Completed as Oil, Gas or Dry Hole) _____

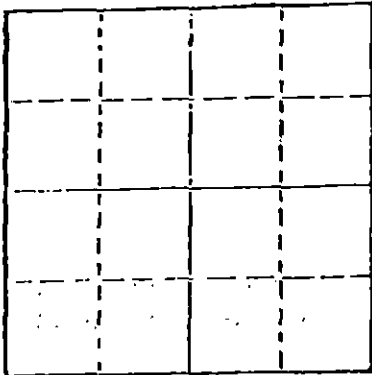

Locate well correctly on above Section Plat

Date Well completed _____ 19____
Application for plugging filed _____ 19____
Application for plugging approved _____ 19____
Plugging commenced 11/16/76 _____ 19____
Plugging completed 11/19/76 _____ 19____
Reason for abandonment of well or producing formation depleted. _____

If a producing well is abandoned, date of last production _____ 19____

Was permission obtained from the Conservation Division or its agents before plugging was commenced? yes

Name of Conservation Agent who supervised plugging of this well Biberstein
Producing formation _____ Depth to top _____ Bottom _____ Total Depth of Well 3980
Show depth and thickness of all water, oil and gas formations.

OIL, GAS OR WATER RECORDS

CASING RECORD

FORMATION	CONTENT	FROM	TO	SIZE	PUT IN	PULLED OUT
				8-5/8	277	none
				5 1/2"	3979	2972'

Describe in detail the manner in which the well was plugged, indicating where the mud fluid was placed and the method or methods used in introducing it into the hold. If cement or other plugs were used, state the character of same and depth placed, from _____ feet to _____ feet for each plug set.

Sanded to 3850' and set 5 sacks cement. Shot pipe at 3221', 3099', 2979', pulled 76 joints. Set rock bridge at 350' and ran 5 yards ready mix.

PLUGGING COMPLETE.

RECEIVED
STATE CORPORATION COMMISSION

DEC 14 1976

CONSERVATION DIVISION
Wichita, Kansas

(If additional description is necessary, use BACK of this sheet)

Name of Plugging Contractor VOTH CASING PULLING
CHASE, KANSAS

STATE OF KANSAS COUNTY OF RICE, ss.
WALTER VOTH (employee of owner) or (owner or operator)
of the above-described well, being first duly sworn on oath, says: That I have knowledge of the facts, statements, and matters herein contained and the log of the above-described well as filed and that the same are true and correct. So help me God.

(Signature) Walter Voth
CHASE, KANSAS

(Address)

SUBSCRIBED AND SWORN TO before me this 13th day of December, 19 76

Margaret Melcher
Notary Public.

My commission expires



DRILLERS LOG

15-095-20526-0000

COMPANY: Maurice L. Brown Company
1500 Vickers KSB&T Building
Wichita, Kansas 67202

LEASE: Kostner 'A' No.1
NE NW NE Sec.30-28S-5W
Kingman County, Kansas

DRILLING CONTRACTOR Slawson Drilling Company, Inc.
408 One Twenty Building
Wichita, Kansas 67202

COMMENCED: 9/27/76

COMPLETED: 10/9/76

TOTAL DEPTH: 3980'

Oil String Run 5 1/2" casing, set at 3979', 150 Sx cement

CASING: 270.52' new 8-5/8" set at 276.52' with 275sx cement

0' to 120' Red Rock & shale
120' to 285' Shale & Shells
270' to 285' cement
285' to 1260' Shale & Shells
1260' to 1515' Shale & Lime
1515' to 1815' Lime & Shale
1815' to 2490' Shale & Lime
2490' to 2900' Lime & Shale
2900' to 3125' Shale & Lime
3125' to 3455' Lime & Shale
3455' to K.C. DST#1 3437-55'
3455' to 3620' Lime & Shale
3620' to 3684' Shale & Lime
3684' to 3860' Lime & Shale
3860' to 3900' Shale & Lime DST #2 3882-3900'.
3900' to 3910' Lime & Shale DST#3 3889-3910'.
3910' to 3945' Miss DST #4 3910-25'
3945' to 3980' Miss DST #5 3926-45'
3980' RTD

RECEIVED
STATE CORPORATION COMMISSION

NOV 17 1976

CONSERVATION DIVISION
Wichita, Kansas

STATE OF KANSAS
COUNTY OF SEDGWICK

I, Rene Stucky, of the Slawson Drilling Company, Inc. upon oath state that the above and foregoing is a true and correct copy of the log of the Kostner 'A' No.1.

Rene Stucky
Rene Stucky

SUBSCRIBED AND SWORN TO ME ON October 16, 1976

Mary Lou Taylor
Mary Lou Taylor, Notary

My commission expires January 17, 1977.

