

STATE OF KANSAS
STATE CORPORATION COMMISSION

WELL PLUGGING RECORD

Give Information Completely
Make Required Affidavit
Mail or Deliver Report to:
Conservation Division
State Corporation Commission
212 No. Market
Wichita, Kansas

KINGMAN

County, Sec. 21 Twp. 28 Rge 5 (E) W (W)

Location as "NE/CNW%SW%" or footage from lines SE NE SW

Lease Owner Arthur Morgenstern Oil Operations

Lease Name REINHOLD Well No. 2

Office Address 511 Union National Bldg., Wichita, Kansas 67202

Character of Well (completed as Oil, Gas or Dry Hole) Oil

Date well completed 3-26-51 19

Application for plugging filed August 4 1970

Application for plugging approved August 5, 1970


Plugging commenced August 10 1970

Plugging completed August 12 1970

Reason for abandonment of well or producing formation

If a producing well is abandoned, date of last production 19

Was permission obtained from the Conservation Division or its agents before plugging was commenced? Yes

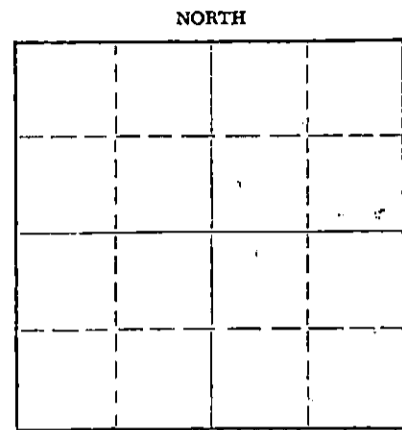

Locate well correctly on above Section Plat

Name of Conservation Agent who supervised plugging of this well Russell Beberstein

Producing formation Mississippi Depth to top 3794 Bottom 3799 Total Depth of Well 3835 Feet

Show depth and thickness of all water, oil and gas formations.

OIL, GAS OR WATER RECORDS

CASING RECORD

FORMATION	CONTENT	FROM	TO	SIZE	PUT IN	PULLED OUT
				8 5/8"	132'	None
				5 1/2"	3825'	3537.25'

Describe in detail the manner in which the well was plugged, indicating where the mud fluid was placed and the method or methods used in introducing it into the hole. If cement or other plugs were used, state the character of same and depth placed, from feet to feet for each plug set.

Rigged up. Filled with sand from 3835' to 3815'. Run 5 sacks of cement from 3815' to 3785'. Working 28" tension. Shot at 3506' & started pipe. Pulled pipe. Set plug at 300'. Rock bridge from 300' to 290'. Run 5 yds. of ready-mix cement from 290' to base of cellar.

RECEIVED
STATE CORPORATION COMMISSION
AUG 26 1970
CONSERVATION DIVISION
Wichita, Kansas

(If additional description is necessary, use BACK of this sheet)

Name of Plugging Contractor GLENN & SMITH PIPE PULLING CO.


Address P. O. Box 156, Ellinwood, Kansas 67526

STATE OF KANSAS, COUNTY OF SEDGWICK, ss. Arthur Morgenstern

(employee of owner) or (owner or operator) of the above-described well, being first duly sworn on oath, says: That I have knowledge of the facts, statements, and matters herein contained and the log of the above-described well as filed and that the same are true and correct. So help me God.

(Signature) Arthur Morgenstern, Owner-Operator
511 Union National Bldg., Wichita, Kansas 67202
(Address)

Subscribed and Sworn to before me this 18th day of August, 1970

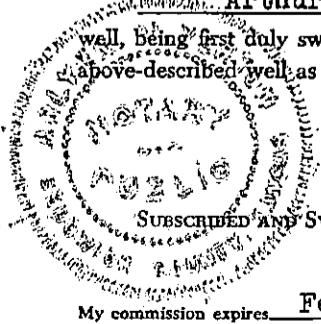

Arlyen M. Yerton, Notary Public.

My commission expires February 18, 1972

15-095-01071-0000

Form CP-3
Rev. 6-4-68

KANSAS

JL
STATE CORPORATION COMMISSION
CONSERVATION DIVISION AGENT'S REPORT

J. Lewis Brock
Administrator
500 Insurance Building
Wichita, Kansas 67202

Operator's Full Name Arthur Morgenstern Oil Operations

Complete Address 511 Union Natl. Bldg. Wichita, Ks

Lease Name Reinhold Well No. 2

Location SE/NE/SW Sec. 21 Twp. 28 Rge. 5 (E) (W)

County Kingman Total Depth 3835

Abandoned Oil Well X Gas Well _____ Input Well _____ SWD Well _____ D & A _____

Other well as hereafter indicated _____

Plugging Contractor Glenn & Smith Pipe Pullers

Address 204 E. 6th Ellinwood, Ks License No. 396

Operation Completed: Hour 3:00 PM Day 12 Month 8 Year 1970

The above well was plugged as follows:

320 ft of 8 5/8 surface pipe cemented with 100 sacks. 3825 ft of
5 1/2 long string cemented with 50 sacks. Open Hole. Sand to 3815, 5
sacks cement with bailer. Pulled 3506 ft of 5 1/2. Set plug at 300 ft.,
10 ft rock bridge. Fill with 5 yds redimix to base of cellar.

RECEIVED
STATE CORPORATION COMMISSION
AUG 13 1970
CONSERVATION DIVISION
Wichita, Kansas

I hereby certify that the above well was plugged as herein stated.

INVOICED

Signed: A. Russell Biberstein
Well Plugging Supervisor

DATE 8/13/70
INV. NO. 2374-W

Reinhold #2
Owner: Earl F. Wakefield
Contractor: Earl F. Wakefield
Comm: 3-14-51 Comp: 3-26-51

SE NE SW 21-28-5
Kingman County, Kansas
Casing: 132' of 8 5/8"
3825' of 8 1/2" w/50

Elevation 1386

Surface	130
Shale	250
Shale & Shells	990
Shale & Lime	1160
Lime & Shale	1415
Shale & Lime	1785
Shale	1910
Shale & Shells	2080
Shale & Lime Streaks	2240
Shale	2255
Shale & Lime	2385
Lime & Shale	3125
Lime	3190
Lime & Shale	3290
Lime & Shale Streaks	3450
Shale & Lime	3575
Lime	3645
Shale & Lime	3795
Top Mississippi	3794
Top of Chert	3800
Top Dolomite	3828
T. D.	3835

RECEIVED
STATE CORPORATION COMMISSION
AUG 5 1970
CONSERVATION DIVISION
Wichita, Kansas

STATE OF KANSAS }
COUNTY OF SEDGWICK) SS

I hereby certify that the above is a true and correct copy of the log of the Reinhold #2 well located SE NE SW 21-28-5, Kingman County, Kansas.

Earl F. Wakefield

Subscribed and sworn to before me this 26th day of March, 1951

E. Jeanne Gaffney
Notary Public

My Commission Expires: 12-23-54