

15-095-00275-0000


STATE OF KANSAS  
STATE CORPORATION COMMISSION

Give All Information Completely  
Make Required Affidavit  
Mail or Deliver Report to:  
Conservation Division  
State Corporation Commission  
800 Bitting Building  
Wichita, Kansas

WELL PLUGGING RECORD

Kingman County. Sec. 20 Twp. 28 Rge. 5 (E) W (W)  
Location as "NE/CNW/SW" or footage from lines NWc  
Lease Owner Greenland Drilling Company  
Lease Name Moorhouse Well No. 1  
Office Address Wichita, Kansas  
Character of Well (completed as Oil, Gas or Dry Hole) Dry Hole  
Date well completed 11/16/54 19  
Application for plugging filed 11/15/54 19  
Application for plugging approved 11/15/54 19  
Plugging commenced 11/16/54 19  
Plugging completed 11/16/54 19  
Reason for abandonment of well or producing formation Dry

NORTH

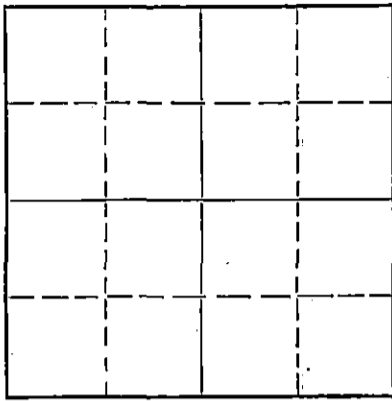

Locate well correctly on above  
Section Flat

If a producing well is abandoned, date of last production \_\_\_\_\_ 19  
Was permission obtained from the Conservation Division or its agents before plugging was commenced? Yes

Name of Conservation Agent who supervised plugging of this well Ruel Durkee  
Producing formation \_\_\_\_\_ Depth to top \_\_\_\_\_ Bottom \_\_\_\_\_ Total Depth of Well 3912 Feet  
Show depth and thickness of all water, oil and gas formations.

OIL, GAS OR WATER RECORDS

CASING RECORD

FORMATION	CONTENT	FROM	TO	SIZE	PUT IN	PULLED OUT

Describe in detail the manner in which the well was plugged, indicating where the mud fluid was placed and the method or methods used in introducing it into the hole. If cement or other plugs were used, state the character of same and depth placed, from \_\_\_\_\_ feet to \_\_\_\_\_ feet for each plug set.

Put in solid bridge plug @ bottom of surface & 15 sacks cement put plug tied on wire line w/5 sacks cement @ top of surface pipe.

(If additional description is necessary, use BACK of this sheet)

Name of Plugging Contractor Greenland Drlg. Co.  
Address Wichita, Kansas

STATE OF KANSAS COUNTY OF SEDGWICK ss.  
RICHARD S. DAVIS (employee of owner) or (owner or operator) of the above-described

well, being first duly sworn on oath, says: That I have knowledge of the facts, statements, and matters herein contained and the log of the above-described well as filed and that the same are true and correct. So help me God.

(Signature) [Signature]  
Wichita, Kansas (Address)

SUBSCRIBED AND SWORN to before me this 22 day of November, 19 54

My commission expires July 8, 1957 [Signature] Notary Public.

24-7366-8 3-53-20M

**PLUGGING**  
FILE SEC 20 T 28 R 5W  
BOOK PAGE 28 LINE 40

NOV 23 1954 11-23-54

15-095-00275-0000

WELL LOG

Lease Owner:	Greenland Drilling Co.	Sec.	20 T 28S R 5W
Contractor:	Greenland Drilling Co.	Loc.	NW
Farm:	Moorhouse Well #1	County	Kingman
Total Depth:	3912'	Elevation:	1117 RB
Comm:	11/2/54	Productions:	D & A
Comp:	11/16/54		
Casing Record:	186' of 8 5/8"		

Figures Indicate Bottom of Formations

195	Red rock & shale
750	Shale w/shells
1420	Lime w/shale breaks
1555	Lime & shale
1605	Lime
1730	Shale w/lime
1820	Shale & shells
3021	Shale & lime
3525	Lime
3567	Lime & shale
3602	Lime
3825	Lime & shale
3862	Miss.
3912	Chert

TDR 3912

TOPS Rotary Bushing

Brown Lime	2995'
Kansas City	3021'
Mississippi	3825'

STATE OF KANSAS )  
 ) ss.  
 COUNTY OF SEDGWICK)

I, Richard S. Davis of the Greenland Drilling Company upon oath state that the above and foregoing is a true and correct copy of the log of the Moorhouse #1 well.

*Richard S. Davis*  
 Richard S. Davis

Subscribed and sworn to before me this 22nd day of November, 1954.

*Mary Ellen Cummins*  
 Notary Public

My commission expires: 7/8/57

**PLUGGING**  
 SEC 20 T 28 R 5W  
 PAGE 28 LINE 40