


15-005-01015-0000

STATE OF KANSAS
STATE CORPORATION COMMISSION

Give All Information Completely
Make Required Affidavit
Mail or Deliver Report to:
Conservation Division
State Corporation Commission
211 No. Broadway
Wichita, Kansas

WELL PLUGGING RECORD

KINGMAN County. Sec. 17 Twp. 28 Rge. (E) 5 (W)
Location as "NE/CNW/SW" or footage from lines C/W 1/2 NW SW
Lease Owner STELBAR OIL CORP., INC., ET AL
Lease Name VINEY Well No. 1
Office Address 310 PETROLEUM BLDG., WICHITA 2, KANSAS
Character of Well (completed as Oil, Gas or Dry Hole) DRY
Date well completed AUGUST 21, 1957
Application for plugging filed AUGUST 22, 1957
Application for plugging approved AUGUST 22, 1957
Plugging commenced AUGUST 22, 1957
Plugging completed AUGUST 22, 1957
Reason for abandonment of well or producing formation

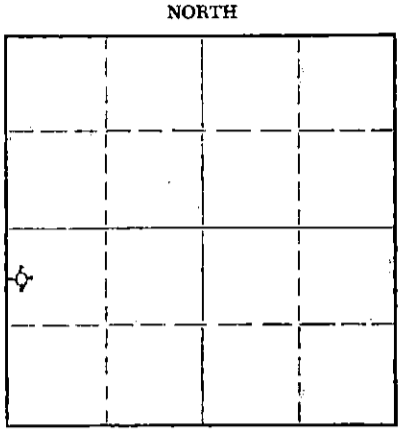

Locate well correctly on above
Section Plat

If a producing well is abandoned, date of last production 19
Was permission obtained from the Conservation Division or its agents before plugging was commenced? M. A. RIVES, PRATT, KANSAS

Name of Conservation Agent who supervised plugging of this well
Producing formation MISSISSIPPI Depth to top 3800 Bottom 3910 Total Depth of Well 3910 Feet
Show depth and thickness of all water, oil and gas formations.

OIL, GAS OR WATER RECORDS

CASING RECORD

FORMATION	CONTENT	FROM	TO	SIZE	PUT IN	PULLED OUT
				8-5/8"	253	NONE

Describe in detail the manner in which the well was plugged, indicating where the mud fluid was placed and the method or methods used in introducing it into the hole. If cement or other plugs were used, state the character of same and depth placed, from feet to feet for each plug set.

FILLED HOLE WITH MUD FROM 3910 T.D. TO 250'.
SET PLUG AT 250', AND PUT IN 20 SACKS OF CEMENT.
FILLED WITH MUD TO 35'. SET SECOND PLUG AT 35'
AND PUT IN 10 SACKS OF CEMENT ON TOP OF PLUG.

(If additional description is necessary, use BACK of this sheet)
Name of Plugging Contractor PRAIRIE OIL & GAS CO., INC.
Address 308 PETROLEUM BLDG., WICHITA 2, KANSAS

STATE OF KANSAS, COUNTY OF SEDGWICK, ss.
BERTRAND M. LESTER, JR. (employee of owner) or (operator) of the above-described well, being first duly sworn on oath, says: That I have knowledge of the facts, statements, and matters herein contained and the log of the above-described well as filed and that the same are true and correct. So help me God.

(Signature) Bertrand M. Lester Jr.
310 PETROLEUM BLDG., WICHITA 2, KANSAS
(Address)

SUBSCRIBED AND SWORN TO before me this 27TH day of AUGUST, 1957
My commission expires DECEMBER 16, 1957
Ray L. Jones
RAY L. JONES Notary Public.

PLUGGING
FILE SEC. 17 T. 28 R. 5W
BOOK PAGE 39 LINE 44

RECEIVED
STATE CORPORATION COMMISSION
AUG 23 1957
CONSERVATION DIVISION
Wichita, Kansas

15-095-01615 0000

STELBAR OIL CORPORATION, INC.

310 PETROLEUM BUILDING
WICHITA 2, KANSAS

LOG

VINEY No. 1, SW/4 Sec. 17-28S-5W, KINGMAN COUNTY, KANSAS
LOCATION: C/W¹/₂ NW SW

OWNER: STELBAR OIL CORP., INC., ET AL DRILLING COMMENCED 8/9/57
CONTRACTOR: PRAIRIE OIL & GAS CO., INC. DRILLING COMPLETED 8/21/57

8-5/8" 253' CEMENTED W/160 SAX ELEVATION: 1408' DF

SURFACE CLAY	40	D & A
BROKEN LIME	253	
SHALE & SHELLS	1291	
SHALE & LIME	1440	
SHALE & SHELLS	3008	
K. C. LIME	3464	
SHALE	3540	
SHALE & LIME	3710	
SHALE	3807	
MISSISSIPPI LIME	3910	RTD

DST #1 3811-3840' OPEN 45 MIN. GAS TO SURFACE IN 2 MIN.
GAUGES 460,000 CU. FT. GAS IN 10 MIN. DROPPED TO 240,000
CU. FT. REC. 190' MUDDY SALT WATER. IBHP 1505#.
FBHP 1245# IN 20 MIN. IFP 95#; FFP 95#.

DST #2 3841-3858' OPEN 1 HR. GOOD BLOW. 2500' OF GAS IN DRILL
PIPE. REC. 180' OIL & GAS CUT WATERY MUD; 10' SALT WATER.
INITIAL SHUT IN PRESSURE 1425# IN 10 MIN. FINAL 190# IN
10 MIN. IFP 30#, FFP 60#.

AUGUST 27, 1957

PLUGGING
FILE SEC 17 T 28 R SW
BOOK PAGE 39 LINE 44

RECEIVED
STATE CORPORATION COMMISSION
WICHITA, KANSAS

AUG 27 1957
CONSERVATION DIVISION
WICHITA, KANSAS