


WELL PLUGGING RECORD

Kingman County, Sec. 17 Twp. 28 Rge. 5 (E) (W)
 Location as "NE/CNW $\frac{1}{4}$ /SW $\frac{1}{4}$ " or footage from lines NE SE NE
 Lease Owner Honaker Drilling Co., Inc., et al
 Lease Name Broadway Well No. 1
 Office Address Great Bend, Kansas
 Character of Well (completed as Oil, Gas or Dry Hole) Dry Hole
 Date well completed 3-29 1951
 Application for plugging filed 3-29 1951
 Application for plugging approved 3-29 1951
 Plugging commenced 3-29 1951
 Plugging completed 3-29 1951
 Reason for abandonment of well or producing formation Dry
 If a producing well is abandoned, date of last production 19...
 Was permission obtained from the Conservation Division or its agents before plugging was commenced? Yes

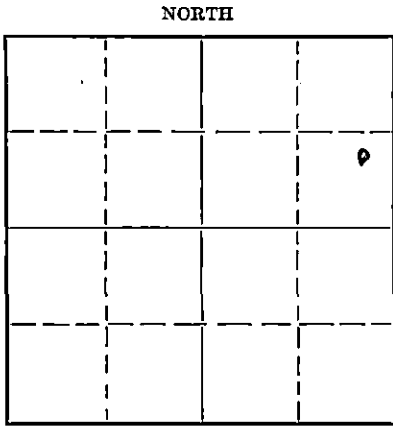

Locate well correctly on above Section Plat

Name of Conservation Agent who supervised plugging of this well Ruel E. Durkee
 Producing formation Depth to top Bottom Total Depth of Well 3849 Feet
 Show depth and thickness of all water, oil and gas formations.

OIL, GAS OR WATER RECORDS

CASING RECORD

Formation	Content	From	To	Size	Put In	Pulled Out

Describe in detail the manner in which the well was plugged, indicating where the mud fluid was placed and the method or methods used in introducing it into the hole. If cement or other plugs were used, state the character of same and depth placed, from...feet to...feet for each plug set.

Filled with heavy mud to 260', set plug with 15 sacks cement. Filled with heavy mud to 20', set another plug and cemented with 5 sacks cement.

RECEIVED
 STATE CORPORATION COMMISSION
 APR - 3 1951
 CONSERVATION DIVISION
 WICHITA, KANSAS

(If additional description is necessary, use BACK of this sheet)
 Correspondence regarding this well should be addressed to Honaker Drilling Co., Inc.
 Address Great Bend, Kansas

STATE OF Kansas, COUNTY OF Barton, ss.
 C. L. Miles (employee of owner) or (owner or operator) of the above-described well,
 being first duly sworn on oath, says: That I have knowledge of the facts, statements, and matters herein contained and the log of the above-described well as filed and that the same are true and correct. So help me God.

(Signature) C. L. Miles
 Great Bend, Kansas
 (Address)

SUBSCRIBED AND SWORN to before me this 30th day of March, 1951

L. L. Laway
 Notary Public.

My commission expires 9-1-54

PLUGGING
 FILE SEC-17 T-28 R-51
 BOOK PAGE 20 LINE 25

DRILLERS LOG

15-045-01738-0000

Operator: Honaker Drilling Co., Inc.
 Lease: Broadway #1
 Contractor: Honaker Drilling Co., Inc.

	From	To
Shale & Sand	0	75
Shale & Sand	75	160

Run 160' 8-5/8" New Spiral weld casing, cemented with 125 sacks cement, 2 sacks CaCl.

Shale	160	475
Shale & Shells	475	560
Shale & Lime	560	665
Anhydrite	665	735
Anhydrite & Lime	735	775
Anhydrite	775	883
Shale & Shells	883	960
Shale	960	1010
Lime	1010	1110
Shale & Lime	1110	1780
Shale	1780	1960
Lime & Shale	1960	2705
Sandy Lime	2705	2805
Lime & Shale	2805	2975
Lime	2975	3430
Shale	3430	3475
Lime & Shale	3475	3510
Shale	3510	3565
Shale & Lime	3565	3849

T. D.

The above is correct to the best of my knowledge.

HONAKER DRILLING CO., INC.

By Joe J. Honaker
 President

RECEIVED
 STATE CORPORATION COMMISSION
 APR - 3 1951
 CONSERVATION DIVISION
 Wichita, Kansas

PLUGGING
 FILE SEC 17T-28R-50
 BOOK PAGE 70 LINE 25