


STATE OF KANSAS  
STATE CORPORATION COMMISSION

WELL PLUGGING RECORD

Give All Information Completely  
Make Required Affidavit  
Mail or Deliver Report to  
Conservation Division  
State Corporation Comm.  
245 North Water  
Wichita, KS 67202

Kingman County, Sec. 9 Twp. 28S Rge. 5W E/W  
Location as "NE/CNW $\frac{1}{4}$ /SW $\frac{1}{4}$ " or footage from lines  
SW NW SW

Lease Owner Big J Production  
Lease Name Viney A Well No. 1  
Office Address 427 North St. Francis Wichita, Kansas 67202  
Character of Well (Completed as Oil, Gas or Dry Hole)  
Dry Hole

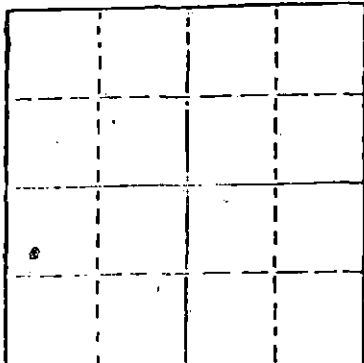

Locate well correctly on above  
Section Plat

Date Well completed 11-2-81 19  
Application for plugging filed 11-2-81 19  
Application for plugging approved 11-2-81 19  
Plugging commenced 11-2-81 19  
Plugging completed 11-2-81 19  
Reason for abandonment of well or producing formation

If a producing well is abandoned, date of last production 19

Was permission obtained from the Conservation Division or its agents before plugging was commenced? Yes

Name of Conservation Agent who supervised plugging of this well Maurise Leslie  
Producing formation Depth to top Bottom Total Depth of Well 4350  
Show depth and thickness of all water, oil and gas formations.

OIL, GAS OR WATER RECORDS

CASING RECORD

FORMATION	CONTENT	FROM	TO	SIZE	PUT IN	PULLED OUT

Describe in detail the manner in which the well was plugged, indicating where the mud fluid was placed and the method or methods used in introducing it into the hold. If cement or other plugs were used, state the character of same and depth placed, from feet to feet for each plug set.

Mud From Bottom To 520 50 Sacks 50-50 Posmix 4% Gel 3% CC  
Mud To 230 40 Sacks 50-50 Posmix 4% Gel 3% CC  
Mud To 40 10 Sacks 50-50 Posmix 4% Gel 3% CC  
10 Sacks In Rat Hole  
5 Sacks In Mouse Hole  
2 Sacks In Water Well

(If additional description is necessary, use BACK of this sheet)

Name of Plugging Contractor Merckle Drilling Co.


STATE OF Kansas COUNTY OF Barton, ss.  
Clyde Merckle (employee of owner) or (owner or operator)  
of the above-described well, being first duly sworn on oath, says: That I have knowledge of the facts, statements, and matters herein contained and the log of the above-described well as filed and that the same are true and correct. So help me God.

(Signature) Clyde Merckle  
Box 1382 Great Bend, Kansas 67530  
(Address)

SUBSCRIBED AND SWORN TO before me this 17<sup>th</sup> day of November, 1981

Notary Public.

My commission expires 3-28-84

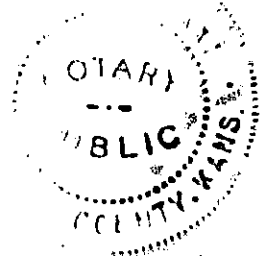

15-095-21184-0000

Big J Production  
427 North St. Francis  
Wichita, Kansas 67202

Viney A1

SW NW SW Section 9 Twp 28S Rge 5W

Kingman County

Driller's Log \_\_\_\_\_ Total Depth 4350'

0-----260 Shale & Shells

260----970 Shale

970----1630 Shale & Lime

1630---2550 Lime & Shale

2550---3170 Lime & Shale

3170---3360 Lime

3360---3790 Lime

3790---3800 Lime & Chert

3800---4350 Lime

*Clyde Merckle*  
Clyde Merckle