


STATE OF KANSAS
STATE CORPORATION COMMISSION

Form CP-4

WELL PLUGGING RECORD

Give All Information Completely
Make Required Affidavit
Mail or Deliver Report to:
Conservation Division
State Corporation Commission
P. O. Box 17027
Wichita, Kansas 67217
NORTH

Kingman County. Sec. 6 Twp. 28S Rge. 5 (E) W (W)
Location as "NE/CNW%SW%" or footage from lines G SW NE
Lease Owner Richard S. Davis
Lease Name Beat Well No. 1
Office Address 1401 Union National Bldg., Wichita, Kansas
Character of Well (completed as Oil, Gas or Dry Hole) Dry Hole
Date well completed 9-13 19 72
Application for plugging filed 9-13 19 72
Application for plugging approved 9-13 19 72
Plugging commenced 9-13 19 72
Plugging completed 9-13 19 72
Reason for abandonment of well or producing formation Dry Hole

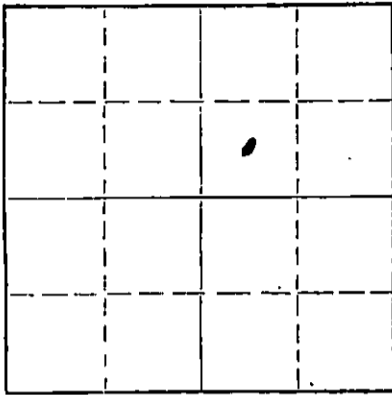

Locate well correctly on above Section Plat

If a producing well is abandoned, date of last production 19
Was permission obtained from the Conservation Division or its agents before plugging was commenced? Yes

Name of Conservation Agent who supervised plugging of this well Russ Beiberstein
Producing formation Depth to top Bottom Total Depth of Well Feet
Show depth and thickness of all water, oil and gas formations.

OIL, GAS OR WATER RECORDS

CASING RECORD

FORMATION	CONTENT	FROM	TO	SIZE	PUT IN	PULLED OUT
Surface pipe		-0-	270	8 5/8"	270	None

Describe in detail the manner in which the well was plugged, indicating where the mud fluid was placed and the method or methods used in introducing it into the hole. If cement or other plugs were used, state the character of same and depth placed, from feet to feet for each plug set.

Filled hole with heavy mud.
#1 plug set @ 350' with 35 sks. cement.
#2 plug set @ 50' with 10 sks. cement.
#3 plug set in rat hole with 2 sks. cement.


RECEIVED
STATE CORPORATION COMMISSION
SEP 18 1972
CONSERVATION DIVISION
Wichita, Kansas

(If additional description is necessary, use BACK of this sheet)
Name of Plugging Contractor Sweetman Drilling, Inc.
Address Box 645, Great Bend, Kansas 67530

STATE OF Kansas, COUNTY OF Barton, ss.
Gary L. Hawk (employee of owner) or (owner or operator) of the above-described well, being first duly sworn on oath, says: That I have knowledge of the facts, statements, and matters herein contained and the log of the above-described well as filed and that the same are true and correct. So help me God.

(Signature) Gary L. Hawk
Box 645, Great Bend, Kansas 67530
(Address)

Subscribed and Sworn to before me this 15th day of September, 19 72

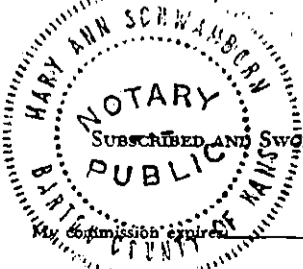

Mary Ann Schwamborn
Notary Public.

WELL LOG
Beat #1
C SW NE 6-28S-5W
Kingman County, Kansas

Name of Operator: Richard S. Davis
1401 Union National Bldg.
Wichita, Kansas 67202

Date Completed: September 13, 1972.

FROM	TO	
0	40	Sand
40	485	Shale and red bed
485	727	Shale
727	2982	Lime and shale
2982	3762	Lime
3762	3784	Miss. Chert
3784		Total Depth

RECEIVED
STATE CORPORATION COMMISSION
SEP 18 1972
CONSERVATION DIVISION
Wichita, Kansas

STATE OF KANSAS

COUNTY OF BARTON ss

Gary L. Hawk, Secretary of Sweetman Drilling, Inc., being first duly sworn on oath says: That I have knowledge of the facts, statements and matters herein contained and the log of the above described well as filed and that the same are true and correct.

Gary L. Hawk

Gary L. Hawk

Subscribed and sworn before me this 15th day of September, 1972.

Mary Ann Schwaborn

Notary Public Barton County

My Commission Expires 7-10-73

