

STATE OF KANSAS
STATE CORPORATION COMMISSION

WELL PLUGGING RECORD

OR

FORMATION PLUGGING RECORD

Strike out upper line
when reporting plugging
off formations.

Give All Information Completely
Make Required Affidavit
Mail or Deliver Report to:
Conservation Division
State Corporation Commission
800 Blitting Building
Wichita, Kansas

Stevens

County. Sec. 22 Twp. 32 Rge. (E) 38 (W)

NORTH

Location as "NE1/4NW1/4SW1/4" or footage from lines 160' West 100' South

Lease Owner Panhandle Eastern Pipe Line Co.

Lease Name Zoller

Well No. 1

Office Address 1221 Baltimore Ave. Kansas City, Missouri

Character of Well (Completed as Oil, Gas or Dry Hole) Not Completed

Date, well completed Not completed

1934.5

Application for plugging filed none filed for record

193

Application for plugging approved

193

Plugging Commenced September 11th

1934.5

Plugging Completed September 21st

193


Reason for abandonment of well or producing formation Lost drill pipe

If a producing well is abandoned, date of last production none

193

Was permission obtained from the Conservation Division or its agents before plugging was commenced?

Yes, R. J. Phillippe, Agent

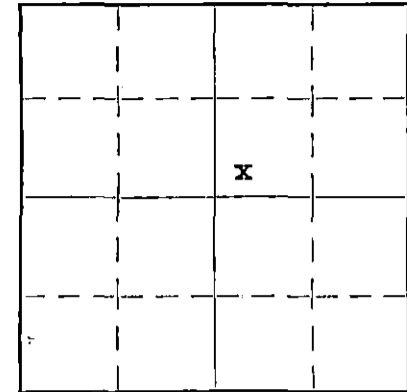

Locate well correctly on above
Section Plat

Name of Conservation Agent who supervised plugging of this well R. J. Phillippe

Producing formation None

Depth to top

Bottom

Total Depth of Well 2078 Feet

Show depth and thickness of all water, oil and gas formations.

OIL, GAS OR WATER RECORDS


CASING RECORD

Formation	Content	From	To	Size	Put In	Pulled Out
				13 3/8"OD	550	None

Describe in detail the manner in which the well was plugged, indicating where the mud fluid was placed and the method or methods used in introducing it into the hole. If cement or other plugs were used, state the character of same and depth placed, from _____ feet to _____ feet for each plug set.

13 3/8 casing set at 550', cemented with 325 sacks from bottom to top.
 Well drilled to 1430' and lost returns, mudded hole and drilled to 1480' and lost returns.
 Mudded hole again and drilled to 2078' with 9 7/8 bit.
 Cemented from bottom of hole to 1504' with 400 sacks
 Reamed hole from bottom of surface pipe (550 ft) to 1535' w/12 1/2" bit.
 Cemented from 1535' to 1770' then drilled to 1717' w/ 9 7/8 bit and lost returns,
 cemented with 100 sacks of cement.
 Started to drill and stuck pipe at 1430', shot off pipe at 1340'.
 Halliburton cemented through drill pipe at 1025' w/25 sacks, pulled drill pipe up to
 550' and cemented w/ 25 sacks of cement
 Filled up to 6' of surface with mud, cut off pipe, and capped with 5 sacks of cement.

PLUGGING
 FILE NO. 22 32 38W
 BOOK PAGE 29 JUL 21

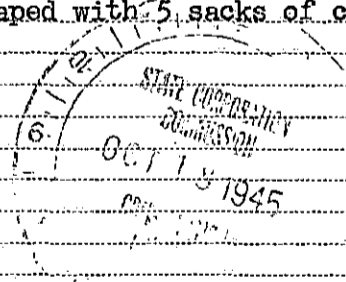

(If additional description is necessary, use BACK of this sheet)

Correspondence regarding this well should be addressed to C. H. Hinton, 1221 Baltimore ave, Kansas City, Mo.
Address

STATE OF Kansas, COUNTY OF Stevens, ss.

(employee of owner) or (owner or operator) of the above-described well,
being first duly sworn on oath, says: That I have knowledge of the facts, statements, and matters herein contained and the log of the above-described well as filed and that the same are true and correct. So help me God.

(Signature) S. H. Neithercot

(Address) Sturgeon Bluff

SUBSCRIBED AND SWORN to before me this 17 day of Oct, 1945

My commission expires May 11, 1947

J. D. Dudley
Notary Public.

