


STATE OF KANSAS
STATE CORPORATION COMMISSION

WELL PLUGGING RECORD

Give All Information Completely
Make Required Affidavit
Mail or Deliver Report to
Conservation Division
State Corporation Comm.
200 Colorado Derby Bldg.
802 W. 1st Street
Wichita, KS 67202

Stevens County, Sec. 25 Twp. 32S Rge. 35 E/W
Location as "NE/CNW $\frac{1}{2}$ SW $\frac{1}{2}$ " or footage from lines

NE SW NE
Lease Owner Mobil Oil Corporation
Lease Name Boles Well No. 2
Office Address P. O. Box 5444 Denver, CO 80217
Character of Well (Completed as Oil, Gas or Dry Hole)
Gas

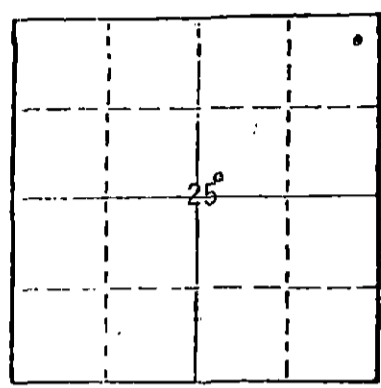

Locate well correctly on above Section Plot

Date Well completed March 20, 1950
Application for plugging filed April 24, 1981
Application for plugging approved May 13, 1981
Plugging commenced 5-28-81 19
Plugging completed 5-29-81 19
Reason for abandonment of well or producing formation
Lost hole

If a producing well is abandoned, date of last production
November 7, 1980

Was permission obtained from the Conservation Division or its agents before plugging was commenced? yes

Name of Conservation Agent who supervised plugging of this well Mr. Thomas
Producing formation Hugoton Chase Depth to top 2590' Bottom 2735' Total Depth of Well 2735'
Show depth and thickness of all water, oil and gas formations.

OIL, GAS OR WATER RECORDS

CASING RECORD

FORMATION	CONTENT	FROM	TO	SIZE	PUT IN	PULLED OUT
Surface casing	1/2# Cellophane +1% CaCl ₂	2	536'	10-3/4"	352sx	0'
Production casing	1/4# Cellophane +4% Gel	2589'	2589'	7"	600sx	0'
	Regular cement		2589'	7"	250sx	

Describe in detail the manner in which the well was plugged, indicating where the mud fluid was placed and the method or methods used in introducing it into the hold. If cement or other plugs were used, state the character of same and depth placed, from _____ feet to _____ feet for each plug set.

Pumped 3 sks. hulls & 25 sks. cement to 2300'
Displaced w/mud to 600'
Pumped 25 sks. cement 600' to 500'
Displaced w/mud to 40'
Put bridge & 15 sks. cement 40' to 0'

RECEIVED
STATE CORPORATION COMMISSION

AUG 7 1981

CONSERVATION DIVISION
Wichita, Kansas

(If additional description is necessary, use BACK of this sheet)

Name of Plugging Contractor Midwest Casing Pulling Service
Permit #766

STATE OF KANSAS COUNTY OF HASKELL, ss.
I, Edgar J. Eves Employee of owner (owner or operator)

of the above-described well, being first duly sworn on oath, says: That I have knowledge of the facts, statements, and matters herein contained and the log of the above-described well as filed and that the same are true and correct. So help me God.

(Signature) Edgar J. Eves
Box F, Sublette, Ks. 67877
(Address)

SUBSCRIBED AND SWORN TO before me this 23rd day of July, 1981

Sandra L. Eves
Notary Public.

My commission expires 12-6-84

