

STATE OF KANSAS  
STATE CORPORATION COMMISSION

WELL PLUGGING RECORD

Give All Information Completely  
Make Required Affidavit  
Mail or Deliver Report to:  
Conservation Division  
State Corporation Commission  
800 Bittling Building  
Wichita, Kansas

Seward County, Sec. 17 Twp. 32 Rge. 32 (E) W (W)

Location as "NE/CNW/SW" or footage from lines 200' NE of Center of SW/4

Lease Owner Prince Brothers Drilling Co.

Lease Name Jones "A" Well No. 1

Office Address Box 992 Electra, Texas

Character of Well (completed as Oil, Gas or Dry Hole) Dry Hole

Date well completed March 22, 1955 19

Application for plugging filed 19

Application for plugging approved April 7 1955


Plugging commenced July 26 1955

Plugging completed July 28 1955

Reason for abandonment of well or producing formation Dry Hole

If a producing well is abandoned, date of last production No production 19

Was permission obtained from the Conservation Division or its agents before plugging was commenced? Yes

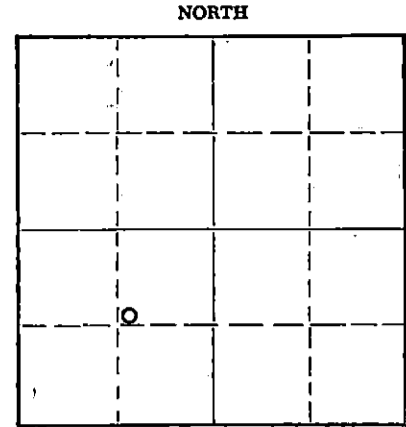

Locate well correctly on above Section Plat

Name of Conservation Agent who supervised plugging of this well R. J. Phillippe

Producing formation Krider Depth to top 2635 Bottom 2673 Total Depth of Well 2690 Feet

Show depth and thickness of all water, oil and gas formations.

OIL, GAS OR WATER RECORDS

CASING RECORD

FORMATION	CONTENT	FROM	TO	SIZE	PUT IN	PULLED OUT
Ogallala	Water	0	495	8 5/8	553	None
Krider	Salt Water	2635	2673	5 1/2	2689	858

Describe in detail the manner in which the well was plugged, indicating where the mud fluid was placed and the method or methods used in introducing it into the hole. If cement or other plugs were used, state the character of same and depth placed, from \_\_\_\_\_ feet to \_\_\_\_\_ feet for each plug set.

Pumped 150 sacks of cement through perforations  
 Top of cement 2540. Mudded up 550 to 2540  
 Rock bridge 540 to 550  
 Dumped 10 sacks of cement 505 to 540  
 Baled dry and tested for water. No water entry.  
 Mudded up 470 to 505  
 Rock bridge 465 to 470  
 Dumped 10 sacks of cement 430 to 465  
 Left hole open for farm water well 0 to 430

(If additional description is necessary, use BACK of this sheet)

Name of Plugging Contractor Arnett Well Plugging

Address Hoisington, Kansas

STATE OF KANSAS, COUNTY OF FINNEY, ss.

R. W. Lange (employee of owner) or (owner) of the above-described

well, being first duly sworn on oath, says: That I have knowledge of the facts, statements, and matters herein contained and the log of the above-described well as filed and that the same are true and correct. So help me God.

(Signature) *R. W. Lange*

Box 434, Garden City, Kansas (Address)

SUBSCRIBED AND SWORN TO before me this 29 day of August 19 55

My commission expires January 28, 1958

*Georgia C. Brown*  
Notary Public.

RECEIVED  
STATE CORPORATION COMMISSION

AUG 30 1955

CONSERVATION DIVISION  
Wichita, Kansas

PLUGGING  
FILE SEC 17 T 32 R 32W  
BOOK PAGE 146 LINE 1

JONES "A" No. 1

Sec 17-32-32W

*dry*

Clay & sand	0	68
Water sand	68	495
Red bed	495	560
Red bed & stks of sand	560	850
Shale & shells	850	925
Shale	925	1183
Shale & salt	1183	1412
Shale & anhydrite	1412	1490
Shale & anhydrite	1490	2007
Anhydrite & shale	2007	2345
Anhydrite & gyp	2345	2624
Dolomite & shale	2624	2652
Dolomite, sand & shale	2652	2690

RECEIVED  
CORPORATION COMMISSION

AUG 30 1955

CONSERVATION DIVISION  
Wichita, Kansas

**PLUGGING**  
 FILE SEC 17-32-32W  
 BOOK PAGE 146 LINE 9