15-095-20035-0000

STATE OF KANSAS
STATE CORPORATION COMMISSION

Give All Information Completely
Make Required Affidavit
Mail or Deliver Report to:
Conservation Division
State Corporation Commission
211 No. Broadway
Wichita, Kansas

WELL PLUGGING RECORD

NORTH

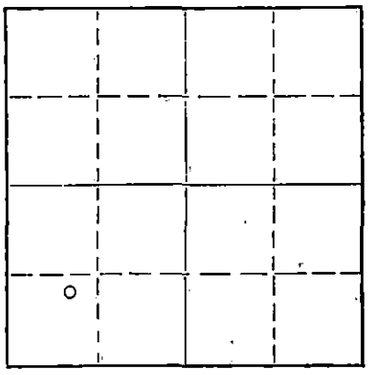

Locate well correctly on above Section Plat

Kingman County. Sec. 31 Twp. 30 Rge. (E) 6 (W)

Location as "NE/CNW¼SW¼" or footage from lines NE SW SW

Lease Owner Colorado Oil Company

Lease Name Prouse Well No. 1

Office Address 915 Union Natl. Bldg., Wichita, Kansas 67202

Character of Well (completed as Oil, Gas or Dry Hole) Dry Hole

Date well completed August 21 19 67

Application for plugging filed August 21 19 67

Application for plugging approved August 21 19 67

Plugging commenced August 21 19 67

Plugging completed August 21 19 67

Reason for abandonment of well or producing formation

If a producing well is abandoned, date of last production 19

Was permission obtained from the Conservation Division or its agents before plugging was commenced? Yes

Name of Conservation Agent who supervised plugging of this well Archie V. Elving

Producing formation Depth to top Bottom Total Depth of Well 4410 Feet

Show depth and thickness of all water, oil and gas formations.

OIL, GAS OR WATER RECORDS

CASING RECORD

FORMATION	CONTENT	FROM	TO	SIZE	PUT IN	PULLED OUT
				8-5/8"	250'	None

RECEIVED
STATE CORPORATION COMMISSION
AUG 28 1967
CONSERVATION DIVISION
Wichita, Kansas

Describe in detail the manner in which the well was plugged, indicating where the mud fluid was placed and the method or methods used in introducing it into the hole. If cement or other plugs were used, state the character of same and depth placed, from feet to feet for each plug set.

4410' to 240' Mud
Bridge @ 240' w/1/2 sack hulls, 2 sacks cement & plug.
23 sacks cement on top of plug.
Mudded to 40'
Bridge @ 40' w/1/2 sack hulls, 1 sack cement & plug.
9 sacks cement to surface.

2 sacks cement in rat hole.

(If additional description is necessary, use BACK of this sheet)

Name of Plugging Contractor Gabbert-Jones, Inc.

Address 830 Sutton Place, Wichita, Kansas 67202

STATE OF Kansas, COUNTY OF Sedgwick, ss.

Bill K. Henrichs (employee of owner) or (owner or operator) of the above-described well, being first duly sworn on oath, says: That I have knowledge of the facts, statements, and matters herein contained and the log of the above-described well as filed and that the same are true and correct. So help me God.

(Signature) Bill K. Henrichs Bill K. Henrichs

915 Union Natl. Bldg., Wichita, Kansas 67202
(Address)

SUBSCRIBED AND SWORN TO before me this 28th day of August, 19 67

Helen L. Martin
Helen L. Martin Notary Public.

My commission expires August 19, 1971

15-095-20035-0000

GABBERT-JONES, INC.
WICHITA, KANSAS
DRILLERS' WELL LOG

PROUSE #1
NE SW SW SECTION 31-30S-6W
KINGMAN COUNTY, KANSAS

COMMENCED: AUGUST 9, 1967
COMPLETED: AUGUST 21, 1967

OPERATOR - COLORADO OIL COMPANY

DEPTH From	DEPTH To	FORMATION	REMARKS
0	105	SAND	
105	250	RED BED	RAN 13 JOINTS OF 8-5/8" CASING, SET @ 250' W/180 SACKS CEMENT.
250	660	RED BED AND SHALE	
660	1225	SHALE AND SHELLS	
1225	3065	LIME AND SHALE	
3065	3198	SHALE	
3198	3569	LIME AND SHALE	
3569	3670	SANDY SHALE	
3670	3801	LIME AND SHALE	
3801	4360	LIME	
4360	4382	CHERTY LIME	
4382	4410	LIME	
4410	TD		DRY AND ABANDONED.

RECEIVED
STATE CORPORATION COMMISSION
AUG 28 1967
CONSERVATION DIVISION
Wichita, Kansas

I, E. E. HALL, CERTIFY THIS IS A CORRECT COPY OF THE DRILLERS' LOG FOR THE WELL DRILLED IN THE NE SW SW SECTION 31-30S-6W, KINGMAN COUNTY, KANSAS, TO THE BEST OF MY KNOWLEDGE AND BELIEF.

E. E. HALL

STATE OF KANSAS)
) SS
COUNTY OF SEDGWICK)

BEFORE ME, THE UNDERSIGNED, A NOTARY PUBLIC WITHIN AND FOR SAID COUNTY AND STATE, ON THIS 24TH DAY OF AUGUST, 1967, PERSONALLY APPEARED E. E. HALL, TO ME PERSONALLY KNOWN TO BE THE IDENTICAL PERSON WHO EXECUTED THE WITHIN AND FOREGOING INSTRUMENT AND ACKNOWLEDGED TO ME THAT HE EXECUTED THE SAME AS HIS FREE AND VOLUNTARY ACT AND DEED FOR THE USES AND PURPOSES THEREIN SET FORTH.

IN WITNESS WHEREOF, I HAVE HEREUNTO SET MY HAND AND OFFICIAL SEAL THE DAY AND YEAR LAST ABOVE WRITTEN.

BARBARA J. LAYTON, NOTARY PUBLIC

MY COMMISSION EXPIRES FEBRUARY 1, 1968.

BARBARA J. LAYTON
NOTARY PUBLIC
SEDGWICK CO., KANSAS