


15-095-20299-0000

STATE OF KANSAS
STATE CORPORATION COMMISSION

Give All Information Completely
Make Required Affidavit
Mail or Deliver Report to:
Conservation Division
State Corporation Commission
211 No. Broadway
Wichita, Kansas

WELL PLUGGING RECORD

NORTH

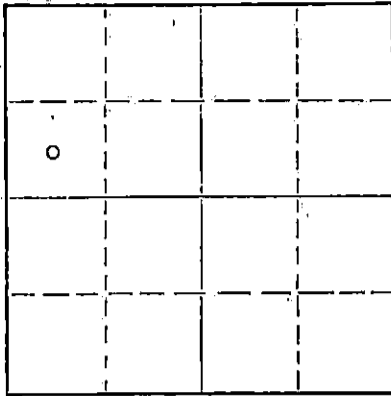

Locate well correctly on above
Section Plat

Kingman County, Sec. 30 Twp. 30 Rge. 6 (E) W (W)
Location as "NE/CNW/SW" or footage from lines C-SW NW
Lease Owner Colorado Oil Company
Lease Name Allender Well No. 1
Office Address 915 Union Natl. Bldg., Wichita, Kansas
Character of Well (completed as Oil, Gas or Dry Hole) Dry Hole
Date well completed April 22 19 66
Application for plugging filed August 4 19 66
Application for plugging approved August 5 19 66
Plugging commenced Sept. 24 19 66
Plugging completed Sept. 28 19 66
Reason for abandonment of well or producing formation

If a producing well is abandoned, date of last production 19
Was permission obtained from the Conservation Division or its agents before plugging was commenced? Yes

Name of Conservation Agent who supervised plugging of this well Archie Elving
Producing formation Depth to top Bottom Total Depth of Well 4725 Feet
Show depth and thickness of all water, oil and gas formations.

OIL, GAS OR WATER RECORDS


CASING RECORD

FORMATION	CONTENT	FROM	TO	SIZE	PUT IN	PULLED OUT
				8-5/8"	213'	None
				4-1/2"	4383'	3402'

Describe in detail the manner in which the well was plugged, indicating where the mud fluid was placed and the method or methods used in introducing it into the hole. If cement or other plugs were used, state the character of same and depth placed, from feet to feet for each plug set.

Checked hole to plug back @ 4272', sanded hole to 4250' and dumped 3 sacks of cement @ 4250' with dump bailer. Pulled 4-1/2" casing, mudded hole to 210', set rock bridge to 200' and dumped 25 sacks of cement. Mudded hole to 40', set rock bridge to 30' and ran 10 sacks of cement to base of cellar.

PLUGGING COMPLETE.

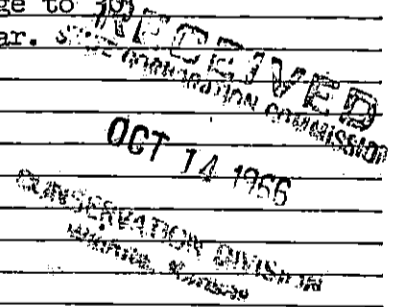

(If additional description is necessary, use BACK of this sheet)

Name of Plugging Contractor Knight Casing Pulling Company
Address Chase, Kansas

STATE OF Kansas, COUNTY OF Sedgwick, ss.
Bill K. Henrichs (employee of owner) or (owner or operator) of the above-described well, being first duly sworn on oath, says: That I have knowledge of the facts, statements, and matters herein contained and the log of the above-described well as filed and that the same are true and correct. So help me God.

(Signature) Bill K. Henrichs
915 Union Natl. Bldg., Wichita, Kansas 67202
(Address)

SUBSCRIBED AND SWORN TO before me this 13th day of October 19 66

Helen L. Martin
Helen L. Martin Notary Public.

My commission expires August 19, 1967



ROTARY DRILLING LOG

OPERATOR: Rains & Williamson Oil Co.
#1 ALLENDER
C SW NW Section 30-30S-6W
Kingman County, Kansas

CONTRACTOR: Rains & Williamson
Oil Co.
COMMENCED: 12-10-65
ROTARY RELEASED: 12-29-65

REMARKS: Set 213' of 8-5/8" surface casing with 200 sacks GL3 cement.

Set 4 1/2" casing @ 4360' with 175 sacks 40-60 posmix.

FORMATIONS:

Surface Soil & Clay	40'
Sand	110'
Shale & Red Bed	1105'
Shale	1118'
Anhydrite	1150'
Shale & Lime	1475'
Lime & Shale	1860'
Shale & Lime	2130'
Shale & Lime Streaks	2430'
Lime & Shale	2555'
Shale & Lime	2825'
Shale	3000'
Shale & Lime	3185'
Lime & Shale	3751'
Lime	4090'
Shale & Lime	4177'
Lime	4525'
Shale	4580'
Shale & Lime	4660'
Sand	4664'
Shale	4674'
Sand	4725'
Rotary Total Depth	4725'

RECEIVED
STATE CORPORATION COMMISSION

AUG 5 1966

CONSERVATION DIVISION
Wichita, Kansas

We certify the above log is true and correct to the best of our knowledge and belief.

RAINS & WILLIAMSON OIL CO.

Wilson Rains
Wilson Rains, Partner

Subscribed and sworn to before me, a Notary Public in and for the State of Kansas, County of Sedgwick, this 3rd day of January, 1966.

My Commission Expires:
January 8, 1968

Shirley Keck
Shirley Keck, Notary Public