

15-095-00355-0000

STATE OF KANSAS
STATE CORPORATION COMMISSION

WELL PLUGGING RECORD

Give All Information Completely
Make Required Affidavit
Mail or Deliver Report to:
Conservation Division
State Corporation Commission
212 North Market, Insurance Bldg.
Wichita, Kansas

Kingman County. Sec. 29 Twp. 30 Rge. (E) 6 (W)

Location as "NE/CNW/SW" or footage from lines C SW SW

Lease Owner Aylward Drilling Company

Lease Name Kalivoda Well No. 1

Office Address 813 1st Nat'l Bank Bldg. - Wichita 2, Kansas

Character of Well (completed as Oil, Gas or Dry Hole) Dry Hole

Date well completed December 8 19 59

Application for plugging filed December 7 19 59

Application for plugging approved December 7 19 59


Plugging commenced December 8 19 59

Plugging completed December 8 19 59

Reason for abandonment of well or producing formation _____

If a producing well is abandoned, date of last production _____ 19 _____

Was permission obtained from the Conservation Division or its agents before plugging was commenced? Yes

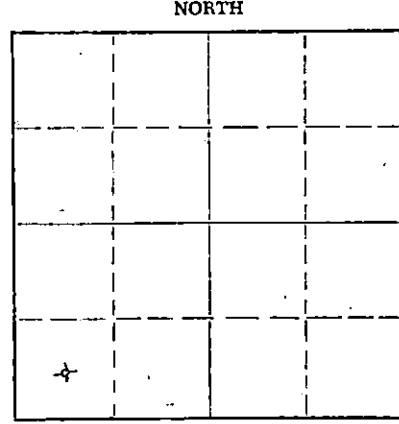

Locate well correctly on above Section Plat

Name of Conservation Agent who supervised plugging of this well Fred Hample - Pretty Prairie, Kansas

Producing formation _____ Depth to top _____ Bottom _____ Total Depth of Well 4885 Feet

Show depth and thickness of all water, oil and gas formations.

OIL, GAS OR WATER RECORDS

CASING RECORD

FORMATION	CONTENT	FROM	TO	SIZE	PUT IN	PULLED OUT
				8 5/8"	237'	None

Describe in detail the manner in which the well was plugged, indicating where the mud fluid was placed and the method or methods used in introducing it into the hole. If cement or other plugs were used, state the character of same and depth placed, from _____ feet to _____ feet for each plug set.

Mud to 220', set plug with 18 sacks cement and 1/4 sack hulls,
mud to 35', set plug with 10 sacks cement and 1/4 sack hulls.
Bridge rat hole and plug with two sacks cement.

RECEIVED
STATE CORPORATION COMMISSION
JAN 21 1960
CONSERVATION DIVISION
Wichita, Kansas

(If additional description is necessary, use BACK of this sheet)
Name of Plugging Contractor Aylward Drilling Company
Address 813 1st Nat'l Bank Bldg. - Wichita 2, Kansas

STATE OF Kansas COUNTY OF Sedgwick, ss.
Charles D. Williams (employee of owner) or (owner or operator) of the above-described well, being first duly sworn on oath, says: That I have knowledge of the facts, statements, and matters herein contained and the log of the above-described well as filed and that the same are true and correct. So help me God.

(Signature) Charles D. Williams
813 1st Nat'l Bank Bldg. - Wichita, Kansas
(Address)

SUBSCRIBED AND SWORN to before me this 14th day of December, 1959

My commission expires December 11, 1961
Duane Jessup Notary Public.

P

KALIVODA NO. 1

Casing Record:

8 5/8" - 237'

Company: Aylward Drilling Company
 Contractor: Aylward Drilling Company

Commenced: November 21, 1959
 Completed: December 7, 1959

Location: C SW SW 29-30-6W
 Kingman County
 Kansas

Elevation: 1557 KB

	<u>From</u>	<u>To</u>	<u>Remarks</u>
Sand	0	50	Set 8 5/8" surface pipe @ 237' w/175 sax cement.
Red Bed & Red Rock	50	239	
Red Bed	239	600	Geological Tops: Log
Shale	600	900	
Anhydrite	900	930	
Shale & Shells	930	1195	
Shale & Lime	1195	1570	
Lime & Shale	1570	2015	
Shale & Lime	2015	2255	
Lime & Shale	2255	2500	
Shale & Lime	2500	2630	
Shale & Sandy Lime	2630	2750	
Shale & Lime	2750	2895	
Shale & Sandy Lime	2895	3050	
Sand & Shale	3050	3120	
Lime & Shale	3120	3185	
Shale & Lime	3185	3550	
Sand	3550	3615	DST 4296-4310 Open 1 hr. fair blow. Rec. 270' SW. 1BHP 1500#/20" - FBHP 1310#/30" ... FP 0#-200#.
Lime & Shale	3615	3795	
Lime	3795	3962	DST 4697-4737 Open 11 hr. Wk. blow. Rec. 80' Wtry mud, 180' MSW. 1BHP 1640#/20" - FBHP 1500#/30" FP. 80#-140#.
Lime & Shale	3962	4018	
Lime	4018	4135	
Lime & Shale	4135	4220	
Shale & Lime	4220	4290	
Lime	4290	4485	
Lime, Cherty	4485	4545	
Chert	4545	4555	
Lime	4555	4590	
Lime & Shale	4590	4645	
Shale & Lime	4645	4713	D & A
Sand	4713	4737	
Lime	4737	4759	
Shale & Sand	4759	4795	
Shale & Lime	4795	4813	
Lime & Shale	4813	4863	
Lime & Dolomite	4863	4885 T.D.	

RECEIVED
 STATE CORPORATION COMMISSION
 JAN 21 1960
 CONSERVATION DIVISION
 Wichita, Kansas

I hereby certify that this is a true and correct copy of the above log to the best of my knowledge.

Paul W. Jesse

Subscribed and sworn to before me this 14th day of December, 1959

Duane Jessup

Notary Public

My commission expires December 11, 1961