


STATE OF KANSAS CORPORATION COMMISSION

WELL PLUGGING RECORD

Give All Information Completely
No. Required Affidavit
Mail or Deliver Report to:
Conservation Division
State Corporation Commission
800 Bittling Building
Wichita, Kansas

Kingman County. Sec. 28 Twp. 30 Rge. 6 (E) (W)
Location as "NE/CNW/SW" or footage from lines SE SE SE
Lease Owner Trans Era Petroleum, Inc.
Lease Name Raida Well No. 1
Office Address Box 232, Russell, Kansas
Character of Well (completed as Oil, Gas or Dry Hole) Dry Hole
Date well completed 8/2/55 19
Application for plugging filed 8/15/55 19
Application for plugging approved 8/15/55 19
Plugging commenced 8/17/55 19
Plugging completed 8/17/55 19
Reason for abandonment of well or producing formation Dry Hole

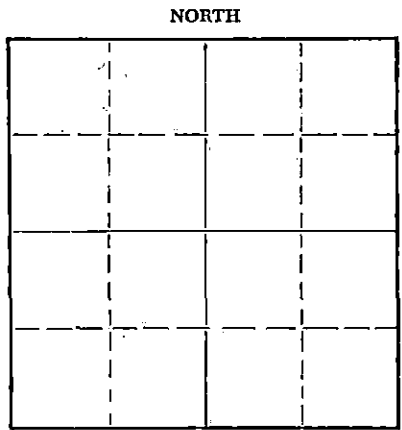

Locate well correctly on above Section Plat

If a producing well is abandoned, date of last production 19
Was permission obtained from the Conservation Division or its agents before plugging was commenced? yes

Name of Conservation Agent who supervised plugging of this well Merle Rives
Producing formation Depth to top Bottom Total Depth of Well 4735 Feet
Show depth and thickness of all water, oil and gas formations.

OIL, GAS OR WATER RECORDS

CASING RECORD

FORMATION	CONTENT	FROM	TO	SIZE	PUT IN	PULLED OUT
				8 5/8	247	none

Describe in detail the manner in which the well was plugged, indicating where the mud fluid was placed and the method or methods used in introducing it into the hole. If cement or other plugs were used, state the character of same and depth placed, from feet to feet for each plug set.

PLUGGING RECORD

Plugged back with crushed rock from 4230' to 4160'. Dumped 5 sax cement with with dump bailer at 4160', top of cement, 4130'. Filled with mud to 240', set rock bridge, dumped 20 sax cement. Top of cement, 190'. Filled with mud to 35', set rock bridge, dumped 10 sax cement for cap.

(If additional description is necessary, use BACK of this sheet)

Name of Plugging Contractor J & M Casing Pulling Company
Address Great Bend, Kansas

STATE OF KANSAS, COUNTY OF RUSSELL, ss.
Robert B. Snyder (employee of owner) or (owner or operator) of the above-described well, being first duly sworn on oath, says: That I have knowledge of the facts, statements, and matters herein contained and the log of the above-described well as filed and that the same are true and correct. So help me God.

(Signature) Robert B. Snyder
(Address)

SUBSCRIBED AND SWORN TO before me this 24th day of August, 19 55

My commission expires 1-30-57

Margie Cooper Notary Public.

PLUGGING
FILE SEC. 28 T. 30 R. 6 W
BOOK PAGE 142 LINE 43

RECEIVED
STATE CORPORATION COMMISSION
AUG 25 1955
CONSERVATION DIVISION
Wichita, Kansas

Trans Era Petroleum, Inc.
Acida 51

Oil No. 22-30-6
Kingman County, Kansas

Total Depth: 4735

Comm: 7/8/53
Comp: 8/2/53

Casing

6 3/8" - 247
5 1/2" - 4300

Cement

150 sacks of Bulk
290 sacks of Cement

FORMATION	DEPTH
Red Bed & Shale	400
Shale	650
Argy & Shale	700
Salt & Shale	835
Shale & Linc	1175
Salt & Shale	1235
Linc	1575
Linc & Shale	3430
Linc	3575
Linc & Shale	3632
Linc	3967
Linc & Shale	4030
Linc	4235
Linc & Chert	4321
Linc	4431
Linc & Shale	4542
Sand	4568
Sand & Shale	4574
Sand	4688
Dandy Shale	4855
Linc	4732
Artichale	4735

STATE OF KANSAS }
COUNTY OF RUSSELL } sec


I hereby certify that the above information is true and correct to the best of my knowledge.

Robert P. Smyke

Subscribed and sworn to before me this 8th day of August, 1953

Margie Cooper
Notary Public

My commission expires: 1-30-57

 

PLUGGING
FILE SEC 28 T 30 R 6W
BOOK PAGE 142 LINE 43