


STATE OF KANSAS
STATE CORPORATION COMMISSION

Give All Information Completely
Make Required Affidavit
Mail or Deliver Report to:
Conservation Division
State Corporation Commission
211 No. Broadway
Wichita, Kansas

WELL PLUGGING RECORD

NORTH

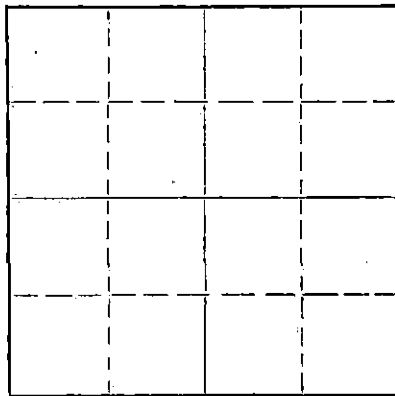

Locate well correctly on above
Section Plat

Kingman County. Sec. 27 Twp. 30S Rge. 6 (E) (W)
Location as "NE/CNW/SW" or footage from lines 2860' E of W 890' N of S
Lease Owner Dorset Co.
Lease Name Holman Well No. 1
Office Address 610 National Bank of Tulsa Bldg., Tulsa, Oklahoma
Character of Well (completed as Oil, Gas or Dry Hole) Dry Hole
Date well completed 4-19-60 19
Application for plugging filed 4-18-60 19
Application for plugging approved 4-18-60 19
Plugging commenced 4-19-60 19
Plugging completed 4-19-60 19
Reason for abandonment of well or producing formation Dry Hole

If a producing well is abandoned, date of last production 19
Was permission obtained from the Conservation Division or its agents before plugging was commenced? yes

Name of Conservation Agent who supervised plugging of this well Fred Hampel
Producing formation _____ Depth to top _____ Bottom _____ Total Depth of Well _____ Feet
Show depth and thickness of all water, oil and gas formations.

OIL, GAS OR WATER RECORDS

CASING RECORD

FORMATION	CONTENT	FROM	TO	SIZE	PUT IN	PULLED OUT

Describe in detail the manner in which the well was plugged, indicating where the mud fluid was placed and the method or methods used in introducing it into the hole. If cement or other plugs were used, state the character of same and depth placed, from _____ feet to _____ feet for each plug set.

Mud 1577' to 240'
Cement 240' to 195'
Mud 195' to 35'
Cement 35' to Surface

Completed 4:00 a.m. 4-19-60

Rotary Plugged

RECEIVED
STATE CORPORATION COMMISSION

APR 21 1960

CONSERVATION DIVISION
Wichita, Kansas

(If additional description is necessary, use BACK of this sheet)

Name of Plugging Contractor McKnab - Lindsay
Address Box 808, Winfield, Kansas

STATE OF Kansas, COUNTY OF Cowley, ss.
V. W. McKnab (employee of owner) or (owner or operator) of the above-described well, being first duly sworn on oath, says: That I have knowledge of the facts, statements, and matters herein contained and the log of the above-described well as filed and that the same are true and correct. So help me God.

(Signature) *V. W. McKnab*
Box 808, Winfield, Kansas
(Address)

SUBSCRIBED AND SWORN TO before me this 20th day of April, 1960

My commission expires Aug. 21, 1961
Mehrad F. ...
Notary Public.



15-095-00143-0000

NE SE NW

HOLMAN #1

2360' East of West Line 890' North of South Line
27-30S-6W
Kingman County, Kansas

Operator: Dorset Company
Contractor: McKnab - Lindsay

Date Comm: 4-2-60
Date Under Surf: 4-3-60
Date Comp: 4-19-60

DRILLER'S LOG:

- 0 - 271 Surface hole
- 271 - 717 - Shale & shells
- 717 - 1020 - Shale
- 1020 - 2660 Shale & lime
- 2660 - 2783 Lime
- 2783 - 3212 Shale & Lime
- 3212 - 3240 Sand
- 3240 - 3370 Shale
- 3370 - 3434 Sand & Shale
- 3434 - 3789 Lime
- 3789 - 3852 Lime and Shale
- 3852 - 3894 Lime
- 3894 - 4151 Lime & Shale
- 4151 - 4439 Miss Lime
- 4439 - 4451 Lime & Shale
- 4451 - 4485 Shale
- 4485 - 4560 Lime & Shale
- 4560 - 4577 Lime
- 4577 T.D.

Cement & Casing record:

12 jts. 8 5/8" 8 RD casing cemented with 225 sks. HA 5 1 8 5/8" centralizer

PLUGGING RECORD:

Mud 4577-240'
Cement 240-195'
Mud 195-35'
Cement 35 to Surface
Completed 4:00 a.m. 4-19-60

Acknowledged:

McKnab & Lindsay

By *W. W. Lindsay*

Date: April 20, 1960

Subscribed and sworn to before me this 20th day of April, 1960.

Melvin L. Lawrence
Notary Public

My Commission expires Aug. 21, 1961.

RECEIVED
STATE CORPORATION SUBMISSION
APR 21 1960
CONSERVATION DIVISION
Topeka, Kansas