

15-095-20167-0000

STATE OF KANSAS
STATE CORPORATION COMMISSION
CONSERVATION DIVISION
200 Colorado Derby Building
Wichita, Kansas 67202

Rev. 12/14/82
FORM CP-1

WELL PLUGGING APPLICATION FORM
File One Copy

API NUMBER N/A 15-095-20167-00-00 (of this well)
(This must be listed; if no API# was issued, please note drilling completion date.)

LEASE OPERATOR Pickrell Drilling Company OPERATORS LICENSE NO. 5123
(was Oasis)

ADDRESS 110 North Market, Suite 205, Wichita, KS PHONE # (316) 262-8427

LEASE (FARM NAME) Linnebur WELL NO. 1

WELL LOCATION C SW SW SEC. 22 TWP. 30S RGE. 6 (~~W~~ or (W))

COUNTY Kingman TOTAL DEPTH 4550' FIELD NAME Wildcat

check one:
OIL WELL GAS WELL INPUT WELL SWD WELL X D&A

IS WELL LOG ATTACHED TO THIS APPLICATION AS REQUIRED? Yes IS ACO-1 FILED? Yes
(If not, explain)

DATE AND HOUR PLUGGING IS DESIRED TO BEGIN June 1, 1983

PLUGGING OF THIS WELL WILL BE DONE IN ACCORDANCE WITH K.S.A. 55-128 OF THE RULES AND REGULATIONS OF THE STATE CORPORATION COMMISSION.

NAME OF COMPANY REPRESENTATIVE AUTHORIZED TO BE IN CHARGE OF PLUGGING OPERATIONS:
Danny Biggs ADDRESS 3807 22nd Street, Great Bend, KS 67530
PHONE # (316) 793-5742

PLUGGING CONTRACTOR Clarke Well Service LICENSE NO. 583
ADDRESS 107 W. Fowler, Medicine Lodge, KS 67104 PHONE # (316) 886-5665

INVOICE COVERING ASSESSMENT FOR PLUGGING THIS WELL SHOULD BE SENT TO:
NAME Pickrell Drilling Company
ADDRESS 110 North Market, Suite 205, Wichita, KS PHONE # (316) 262-8427

AND PAYMENT WILL BE GUARANTEED BY APPLICANT OR ACTING AGENT.


RECEIVED
STATE CORPORATION COMMISSION

SIGNED: Jack Gurley
(Applicant or Acting Agent)
Jack Gurley - Engineer
DATE: April 7, 1983

APR 08 1983
CONSERVATION DIVISION
Wichita, Kansas

W E L L S K E T C H

Linnebur No. 1

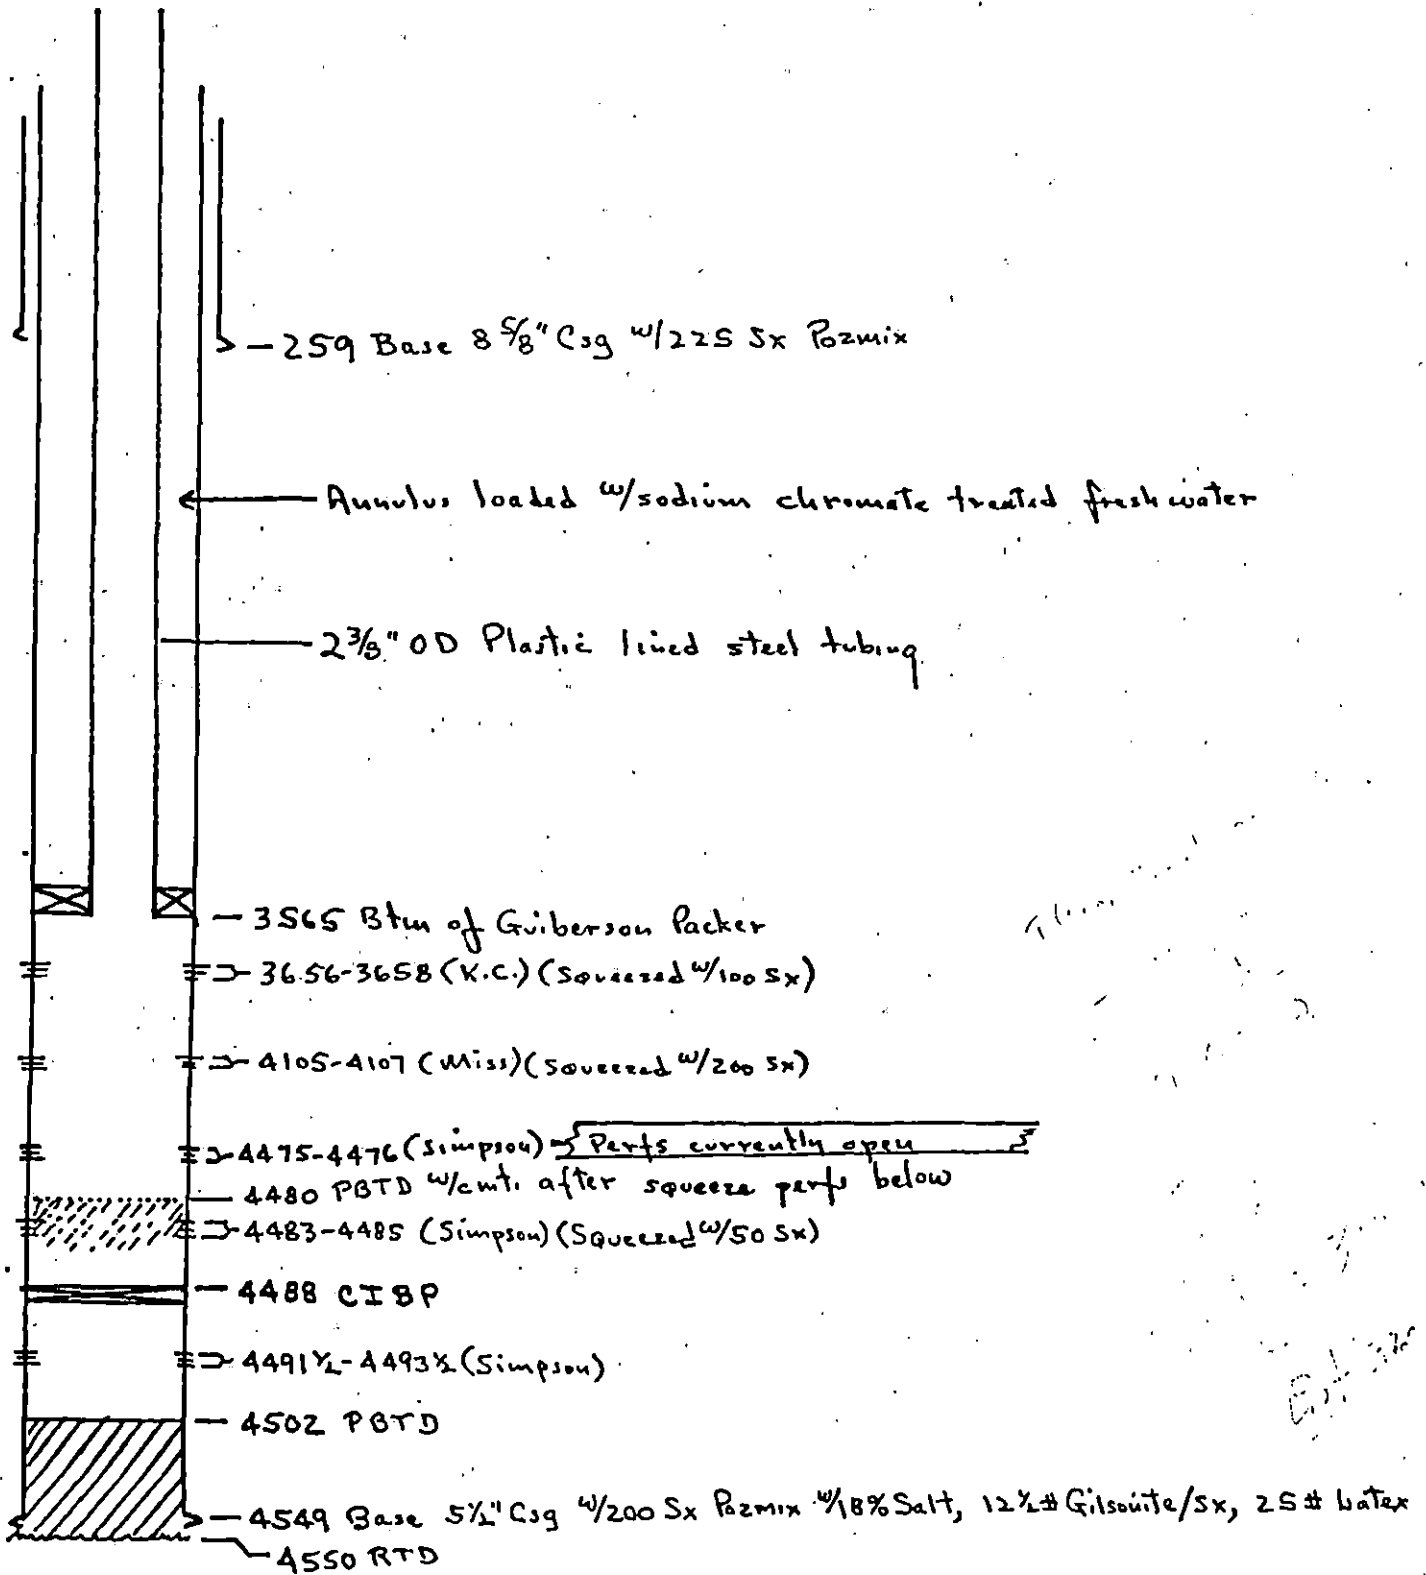

State of Kansas



JOHN CARLIN
MICHAEL LENIHEN
R. C. (PETE) LOUX
PHILLIP R. DICK
JUDITH MCCORRELL
BRIAN J. MOLINE

GOVERNOR
CHAIRMAN
COMMISSIONER
COMMISSIONER
EXECUTIVE SECRETARY
GENERAL COUNSEL

State Corporation Commission

CONSERVATION DIVISION

(Oil, Gas and Water)
200 Colorado Derby Building
202 West 1st Street
WICHITA, KANSAS 67202-1286

THIS PERMIT

SEP 13 1983

EXPIRES

June 13, 1983

WELL PLUGGING NOTICE

Linnebur #1
C SW SW
Sec. 22-30S-6W
Kingman Co., Ks.
T.D. 4550'
Clarke Well Service

Pickrell Drilling Company
110 North Market
Suite 205
Wichita, Kansas 67202

Gentlemen:

This is your notice to plug the above subject well in accordance with the Rules and Regulations of the State Corporation Commission.

This notice is void after ninety (90) days from the above date.

Yours very truly,

Carol J. Larson, Administrator

Please submit your proposal for plugging the above captioned well to

KCC/KDHE Dist. #2, 202 Century Plaza, 111 W. Douglas, Wichita, Ks. 67201
seven days prior to plugging the well (KAR-82-3-113)

CC: Didst. #2