


STATE OF KANSAS
STATE CORPORATION COMMISSION

Give All Information Completely
Make Required Affidavit
Mail or Deliver Report to:
Conservation Division
State Corporation Commission
211 No. Broadway
Wichita, Kansas

WELL PLUGGING RECORD

KINGMAN County, Sec. 31 Twp. 29s Rge. 8w (X) (W)

NORTH

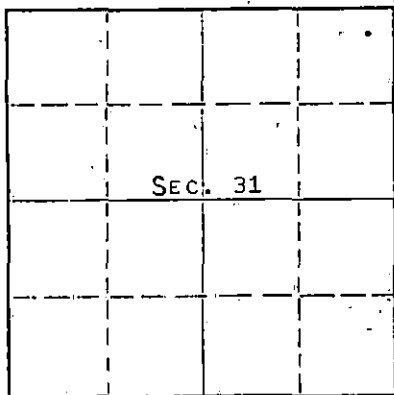

Locate well correctly on above
Section Plat

Location as "NE/CNWSW" or footage from lines NE NE NW
Lease Owner PETROLEUM, INC.
Lease Name CORNELIUS "B" Well No. 1
Office Address ROUTE 2, GREAT BEND, KANSAS
Character of Well (completed as Oil, Gas or Dry Hole) DRY HOLE
Date well completed APRIL 14, 19 63
Application for plugging filed APRIL 14, 19 63
Application for plugging approved APRIL 14, 19 63
Plugging commenced APRIL 14, 19 63
Plugging completed APRIL 14, 19 63
Reason for abandonment of well or producing formation NO PRODUCIBLE FORMATIONS

If a producing well is abandoned, date of last production NONE 19
Was permission obtained from the Conservation Division or its agents before plugging was commenced? YES

Name of Conservation Agent who supervised plugging of this well ARCHIE ELVING
Producing formation - - Depth to top - - Bottom - - Total Depth of Well 4227 Feet
Show depth and thickness of all water, oil and gas formations.

OIL, GAS OR WATER RECORDS

CASING RECORD

FORMATION	CONTENT	FROM	TO	SIZE	PUT IN	PULLED OUT
				8-5/8"	258'	NONE

Describe in detail the manner in which the well was plugged, indicating where the mud fluid was placed and the method or methods used in introducing it into the hole. If cement or other plugs were used, state the character of same and depth placed, from _____ feet to _____ feet for each plug set.

MUDDED UP WITH HEAVY MUD TO 180' FOLLOWED BY WOODEN PLUG AND 1/4 SACK HULLS. PLACED 20 SACKS OF CEMENT THROUGH DRILL PLUG ONTO HULLS. MUDDED UP WITH HEAVY MUD TO 40' FOLLOWED BY WOODEN PLUG, 1/4 SACK HULLS AND 8 SACKS CEMENT TO BASE OF WELL CELLAR. PLUG RAT HOLE WITH 2 SACKS CEMENT.

RECEIVED
STATE CORPORATION COMMISSION

MAY 3 1963

CONSERVATION DIVISION
Wichita, Kansas

(If additional description is necessary, use BACK of this sheet)

Name of Plugging Contractor GARVEY DRILLING COMPANY
Address ROUTE 2, GREAT BEND, KANSAS

STATE OF KANSAS COUNTY OF BARTON, ss.
DON SEARLE (employee of owner) or (~~owner or operator~~) of the above-described

well, being first duly sworn on oath, says: That I have knowledge of the facts, statements, and matters herein contained and the log of the above-described well as filed and that the same are true and correct. So help me God. DON SEARLE, DIST. PROD. SUPT.

(Signature) Don Searle
ROUTE 2, GREAT BEND, KANSAS
(Address)

SUBSCRIBED AND SWORN TO before me this 1ST day of MAY, 19 63

My commission expires APRIL 14, 1967 Arthur J. Mills Notary Public.

15-095-01265-0000
WELL LOG

COMPANY Petroleum Inc

SEC. 31 T. 29S. 8W

FARM Cornelius NO. B-1


LOC. NE NE NW

TOTAL DEPTH 4227'

COUNTY Kingman

COMM. 4-3-63 COMP. 4-14-63

CONTRACTOR Garvey Drilling Company

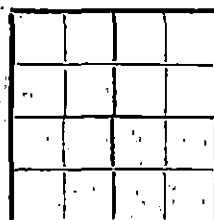

CASING 8 5/8" @ 258' w/150 sx

ELEVATION 1618' DF

PRODUCTION D & A

FIGURES INDICATE BOTTOM OF FORMATIONS

- 40' Sand and Clay
- 60' Sand
- 258' Red Bed and Clay
- 760' Red Bed and Shale
- 1410' Shale and Shells
- 1575' Lime and Shale
- 1740' Shale and Lime
- 2230' Lime
- 2450' Shale and Shells
- 2610' Shale and Lime
- 3966' Lime
- 4107' Lime and Shale
- 4183' Lime
- 4208' Mississippi Chert
- 4227' Mississippi
- 4227' RTD

RECEIVED
STATE CORPORATION COMMISSION

MAY 3 1963

CONSERVATION DIVISION
Wichita, Kansas

State of Kansas }
County of Barton } ss

I, Sam N. Stephens of Garvey Drilling Company

upon oath state the above and foregoing is a true and correct copy of the log of the Cornelius B-1 well.

Sam N. Stephens

Subscribed and sworn to before me this 24th day of April 19 63

My Commission Expires: April 14th, 1967

Arthur J. Orselle
NOTARY PUBLIC