

15-095-01286-0000


STATE OF KANSAS
STATE CORPORATION COMMISSION

WELL PLUGGING RECORD

Give All Information Completely
Make Required Affidavit
Mail or Deliver Report to:
Conservation Division
State Corporation Commission
211 No. Broadway
Wichita, Kansas

Kingman County, Sec. 31 Twp. 29S Rge. (E) 8 (W)

NORTH

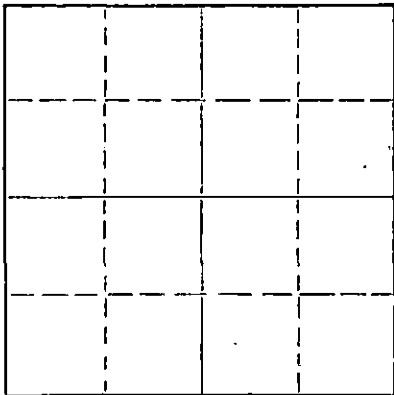

Locate well correctly on above
Section Plat

Location as "NE/CNW/SW" or footage from lines 0 SE NW
Lease Owner Phillips Petroleum Company
Lease Name Cornelius Well No. 1
Office Address Box 779 - Great Bend, Kansas.
Character of Well (completed as Oil, Gas or Dry Hole) Dry Hole
Date well completed July 24, 1958 19
Application for plugging filed July 22, 1958 19
Application for plugging approved July 25, 1958 19
Plugging commenced July 29, 1958 19
Plugging completed August 1, 1958 19
Reason for abandonment of well or producing formation Dry Hole

If a producing well is abandoned, date of last production ----- 19
Was permission obtained from the Conservation Division or its agents before plugging was commenced? Yes

Name of Conservation Agent who supervised plugging of this well Mr. Fred Hampel - Pretty Prairie, Kansas.
Producing formation Miss. Chert Depth to top 4189 Bottom -- Total Depth of Well 4250 Feet
Show depth and thickness of all water, oil and gas formations.

OIL, GAS OR WATER RECORDS

CASING RECORD

FORMATION	CONTENT	FROM	TO	SIZE	PUT IN	PULLED OUT
Heebner	Dry	3284		8 5/8	331	none
Toronto	Dry	3301		5 1/2	8248	3699'
Douglas	Dry	3341				
Br. Lime	Dry	3497				
LKC	Dry	3504				
Base LKC	Dry	3962				
Cherokee	Dry	4109				
Miss Chert	Dry	4189				
Miss. Lime	Dry	4208				

Describe in detail the manner in which the well was plugged, indicating where the mud fluid was placed and the method or methods used in introducing it into the hole. If cement or other plugs were used, state the character of same and depth placed, from _____ feet to _____ feet for each plug set.

Set cast iron bridge plug at 4170', dumped 2 sx. cement in filling to 4154'.
Mudded hole from 4154' to 325'. Set 10' rock bridge to 315'. Dumped 20 sx.
cement in filling to 250'. Mudded hole to 35'. Set 5' rock bridge to 30'.
Dumped 10 sx. cement in filling to base of cellar.

(If additional description is necessary, use BACK of this sheet)

Name of Plugging Contractor West Supply
Address Chase, Kansas.

STATE OF KANSAS, COUNTY OF BARTON, ss.
A. J. Willis (employee of owner) or owner/operater of the above-described well, being first duly sworn on oath, says: That I have knowledge of the facts, statements, and matters herein contained and the log of the above-described well as filed and that the same are true and correct. So help me God.

(Signature) Willis
Box 779 Great Bend, Kansas.
(Address)

SUBSCRIBED AND SWORN to before me this 5th day of August, 19 58

My commission expires 11/18/61 Notary Public.

RECEIVED
STATE CORPORATION COMMISSION
AUG 6 1958
CONSERVATION DIVISION
Wichita, Kansas

PLUGGING
FILE SEC 31 T 29 R 8W
BOOK PAGE 117 LINE 40

EXPLORATION RECORD

Lease Cornelius

Well 1

Formation Name	Top	Base	Remarks
Surface Clay and Rock	0	40	
Red Rock	40	65	
Red Bed	65	332	
Red Bed	332	455	
Red Bed and Shale	455	1040	
Shale and Shells	1040	1160	
Anhydrite with Shale Streaks	1160	1500	
Shale and Lime	1500	1610	
Lime	1610	1760	
Shale and Lime	1760	1990	
Lime	1990	2055	
Shale and Lime	2055	3110	
Lime	3110	3380	
Shale and Lime	3380	3510	
Lime	3510	3965	
Shale and Shells	3965	3995	
Shale and Lime	3995	4196	
Lime	4196	4250	

PLUGGING
 FILE SEC. 31 T. 29 R. BW
 BOOK PAGE 1 LINE 40

RECEIVED
 STATE CORPORATION COMMISSION
 AUG 6 1958
 CONSERVATION DIVISION