


15-695-00075-0000

STATE OF KANSAS CORPORATION COMMISSION

WELL PLUGGING RECORD

Give All Information Completely Make Required Affidavit Mail or Deliver Report to: Conservation Division State Corporation Commission 800 Bitting Building Wichita, Kansas

NORTH

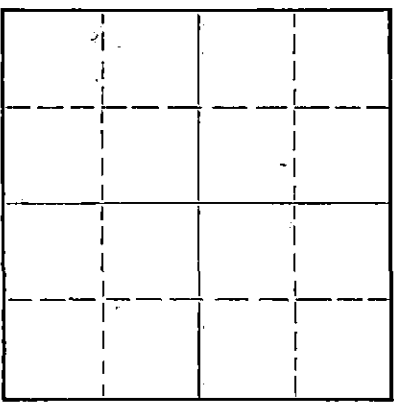

Locate well correctly on above Section Plat

Kingman County. Sec. 30 Twp. 29S Rge. 8 (E) (W) Location as "NE/CNW/SW" or footage from lines NE NE SE Lease Owner Rupp-Ferguson Oil Co. Lease Name Shepard Well No. 1 Office Address 523 Petroleum Building, Wichita, Kansas Character of Well (completed as Oil, Gas or Dry Hole) Dry Hole Date well completed 5-24-55 Application for plugging filed 5-24-55 Application for plugging approved 5-24-55 Plugging commenced 5-24-55 Plugging completed 5-24-55 Reason for abandonment of well or producing formation

If a producing well is abandoned, date of last production 19 Was permission obtained from the Conservation Division or its agents before plugging was commenced? Yes

Name of Conservation Agent who supervised plugging of this well Producing formation Depth to top Bottom Total Depth of Well 4666 Feet Show depth and thickness of all water, oil and gas formations.

OIL, GAS OR WATER RECORDS

CASING RECORD

Table with 7 columns: FORMATION, CONTENT, FROM, TO, SIZE, PUT IN, PULLED OUT. Row 1: 8-5/8", 231', 0

Describe in detail the manner in which the well was plugged, indicating where the mud fluid was placed and the method or methods used in introducing it into the hole. If cement or other plugs were used, state the character of same and depth placed, from feet to feet for each plug set.

Filled hole with mud to 225'. Put in hulls. Plugged. Cemented through drill pipe. Filled with mud to 35'. Put in hulls. Cemented to base of cellar.

STATE OF KANSAS

6-4-55

(If additional description is necessary, use BACK of this sheet)

Name of Plugging Contractor Rupp-Ferguson Oil Co. Address 523 Petroleum Building, Wichita, Kansas

STATE OF Kansas, COUNTY OF Sedgwick, ss. I. W. Knox (employee of owner) or (owner or operator) of the above-described well, being first duly sworn on oath, says: That I have knowledge of the facts, statements, and matters herein contained and the log of the above-described well as filed and that the same are true and correct. So help me God.

(Signature) L.P. Knox 523 Petroleum Building, Wichita, Kansas (Address)

SUBSCRIBED AND SWORN to before me this 24th day of May 19 55

Notary Public signature

My commission expires September 24, 1956

PLUGGING FILED DEC 30 1955 ESCK HAS/22 LHM 4

CONTRACTOR'S WELL LOG

Rupp-Ferguson No. 1 Shepard
NE NE SE, Sec. 30-29S-8W,
Kingman County, Kansas

Elevation: 1586 DF
1589 KB

Commenced: 5-8-55
Completed: 5-24-55

D & A

Contractor: Rupp-Ferguson Oil Co.

Set 231' of 8-5/8" casing with 210 sacks cement

Figures indicate Bottom of Formation

230	surface hole		
1400	shale & shells		
1530	lime		
1920	lime & shale	Heebner (2nd)	3239 (-1650)
3000	shale & lime	Douglas	3300 (-1711)
3320	lime	Brown Lime	3468 (-1870)
3475	sand, lime & shale	Lansing-Kansas City	3476 (-1887)
4050	lime	Mississippian	4186 (-2597)
4170	lime & shale	Kinderhook	4342 (-2753)
4400	Mississippi	Viola	4466 (-2877)
4520	shale	Simpson Sand	4512 (-2923)
4666	Simpson	Simpson Shale	4560 (-2971)
	T.D.	Arbuckle	4630 (-3041)
		Total Depth	4667 (-3078)

RECEIVED
STATE COMMISSION
JUN 14 1955
DIVISION

DST 4186-4200/1 hr. Rec. 125' fluid,
top half frothy mud and lower half
muddy salt water. IFP OK. EFP 45#.
BHP 1275#. HSH 2270#.

STATE OF KANSAS)
) SS.
COUNTY OF SEDGWICK)

I, L. W. Knox, Landman for Rupp-Ferguson Oil Co., do hereby certify that
the above and foregoing is a true and correct copy of the log of the No. 1
Shepard well.

L. W. Knox
L. W. Knox

Subscribed and sworn to before me this 2nd day of June, 1955.

Wm. L. Stinson
Notary Public

My Commission Expires: September 24, 1956

PLUGGING
FILE SEC 30-29-8W
BOOK PAGE 122 LINE 4