


Give All Information Completely
Make Required Affidavit
Mail or Deliver Report to:
Conservation Division
State Corporation Commission
211 No. Broadway
Wichita, Kansas

WELL PLUGGING RECORD

KINGMAN County. Sec. 29 Twp. 29S Rge. (X) 8 (W)

Location as "NE/CNWSW" or footage from lines C S/2 SE SE
Lease Owner PETROLEUM, INC.
Lease Name GRIFFITH UNIT Well No. 1
Office Address ROUTE #2, GREAT BEND, KANSAS
Character of Well (completed as Oil, Gas or Dry Hole) DRY HOLE
Date well completed NOVEMBER 13, 1964
Application for plugging filed NOVEMBER 13, 1964
Application for plugging approved NOVEMBER 13, 1964
Plugging commenced NOVEMBER 13, 1964
Plugging completed NOVEMBER 13, 1964
Reason for abandonment of well or producing formation NO PRODUCIBLE ZONES

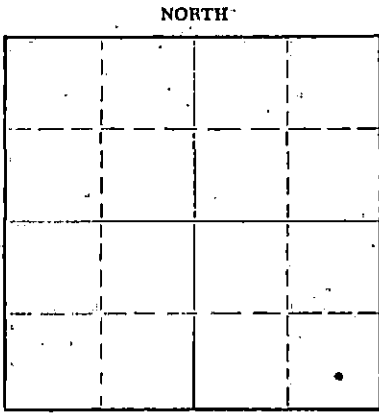

Locate well correctly on above Section Plat

If a producing well is abandoned, date of last production - 19
Was permission obtained from the Conservation Division or its agents before plugging was commenced? YES

Name of Conservation Agent who supervised plugging of this well ARCHIE ELVING, BOX 248, PRATT, KANSAS
Producing formation - Depth to top - Bottom - Total Depth of Well 4350 Feet
Show depth and thickness of all water, oil and gas formations.

OIL, GAS OR WATER RECORDS

CASING RECORD

FORMATION	CONTENT	FROM	TO	SIZE	PUT IN	PULLED OUT
				8-5/8"	221'	NONE

Describe in detail the manner in which the well was plugged, indicating where the mud fluid was placed and the method or methods used in introducing it into the hole. If cement or other plugs were used, state the character of same and depth placed, from feet to feet for each plug set.

MUDDED UP WITH HEAVY MUD, THRU DRILL PIPE TO 225', FOLLOWED BY A WOODEN PLUG, 1/4 SACK HULLS AND 25 SACKS CEMENT. MUDDED UP WITH HEAVY MUD THRU DRILL PIPE TO 40', FOLLOWED BY A WOODEN PLUG, 1/4 SACK HULLS AND 10 SACKS CEMENT TO BASE OF WELL CELLAR.

RECEIVED
STATE CORPORATION COMMISSION

NOV 25 1964

CONSERVATION DIVISION
Wichita, Kansas

(If additional description is necessary, use BACK of this sheet)
Name of Plugging Contractor GARVEY DRILLING COMPANY
Address ROUTE #2, GREAT BEND, KANSAS

STATE OF KANSAS, COUNTY OF BARTON, ss.
MONTE CHADD (employee of owner) or (owner's agent) of the above-described

well, being first duly sworn on oath, says: That I have knowledge of the facts, statements, and matters herein contained and the log of the above-described well as filed and that the same are true and correct. So help me God. MONTE CHADD, DIST. PROD. SUPT.

(Signature) [Signature]
ROUTE #2, GREAT BEND, KANSAS
(Address)

Subscribed and Sworn to before me this 24 day of NOVEMBER, 1964

[Signature]
Notary Public.

My commission expires OCTOBER 19, 1968



WELL LOG

9

COMPANY Petroleum, Inc.

SEC. 29 T. 29S R. 8W

FARM Griffith K-1

NO. K-1

LOC. S/2 SE SE
Approx.


TOTAL DEPTH 4350'

COUNTY Kingman

COMM. 10-31-64

COMP. 11-13-64

CONTRACTOR Garvey Drilling Company

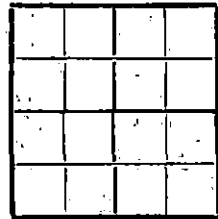

CASING 8 5/8" @ 221' w/200 sx

ELEVATION

PRODUCTION D & A

FIGURES INDICATE BOTTOM OF FORMATIONS

- 40' Surface Clay and Sand
- 221' Red Bed
- 1125' Red Bed and Shale
- 1290' Shale
- 1590' Lime
- 1840' Lime and Shale
- 2299' Shale and Lime
- 2340' Sand
- 2867' Shale and Lime
- 3520' Lime and Shale
- 4139' Lime
- 4146' Shale and Lime
- 4243' Lime and Shale
- 4258' Chert
- 4278' Chert and Lime
- 4303' Chert
- 4350' Chert and Lime
- 4350' RTD

RECEIVED
STATE CORPORATION COMMISSION

NOV 25 1964

CONSERVATION DIVISION
Wichita, Kansas

State of Kansas }
County of Barton } ss

I, Sam N. Stepheas of Garvey Drilling Company
upon oath state the above and foregoing is a true and correct copy of the log of the Griffith K-1 well.

Sam N. Stepheas

Subscribed and sworn to before me this 18th day of November 1964

My Commission Expires October 19th, 1968

Lawrence D. Sherman
NOTARY PUBLIC

