


Give All Information Completely
Make Required Affidavit
Mail or Deliver Report to:
Conservation Division
State Corporation Commission
P. O. Box 17027
Wichita, Kansas 67217
NORTH

WELL PLUGGING RECORD

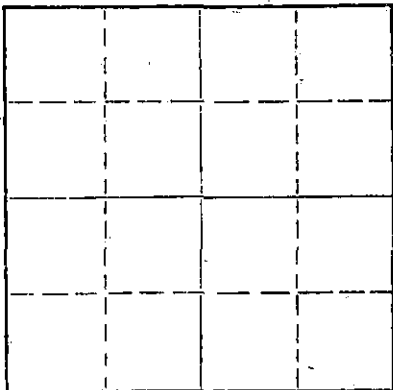

Locate well correctly on above
Section Plat

Kingman County, Sec. 7 Twp. 29S Rge. 10W (E) (W)
Location as "NE/CNW/SW" or footage from lines C SW 7/4
Lease Owner Ronald Russ Prater, Inc.
Lease Name Schnittker Well No. 1
Office Address 240 N. Rock Road, Wichita, Kansas
Character of Well (completed as Oil, Gas or Dry Hole) Dry Hole
Date well completed November 22 19 76
Application for plugging filed November 22 19 76
Application for plugging approved November 22 19 76
Plugging commenced November 22 19 76
Plugging completed November 22 19 76
Reason for abandonment of well or producing formation Dry Hole

If a producing well is abandoned, date of last production 19
Was permission obtained from the Conservation Division or its agents before plugging was commenced? Yes, verbally

Name of Conservation Agent who supervised plugging of this well G. R. Biberstein
Producing formation Depth to top Bottom Total Depth of Well 3820 Feet
Show depth and thickness of all water, oil and gas formations.

OIL, GAS OR WATER RECORDS

CASING RECORD

FORMATION	CONTENT	FROM	TO	SIZE	PUT IN	PULLED OUT
				8-5/8"	300	

Describe in detail the manner in which the well was plugged, indicating where the mud fluid was placed and the method or methods used in introducing it into the hole. If cement or other plugs were used, state the character of same and depth placed, from feet to feet for each plug set.

1st plug set at 250 with 35 sacks
2nd plug set at 40 with 20 sacks, 5 sacks in rathole

RECEIVED
STATE CORPORATION COMMISSION
DEC 20 1976
CONSERVATION DIVISION
Wichita, Kansas

(If additional description is necessary, use BACK of this sheet)

Name of Plugging Contractor Union Drilling Co., Inc.
Address 505 Union Center, Wichita, Kansas 67202

STATE OF KANSAS, COUNTY OF SEDGWICK, ss.
R. D. Messinger (employee of owner) or (owner or operator) of the above-described well, being first duly sworn on oath, says: That I have knowledge of the facts, statements, and matters herein contained and the log of the above-described well as filed and that the same are true and correct. So help me God.

(Signature) R. D. Messinger
505 Union Center, Wichita, Kansas (Address)

SUBSCRIBED AND SWORN to before me this 29th day of November, 19 76

My commission expires July 29, 1978 Donna F. Brown Notary Public.

CONTRACTOR'S WELL LOG

OPERATOR: Ronald Russ Prater, Inc.
 CONTRACTOR: Union Drilling Co., Inc.
 WELL NAME: Schnittker #1
 LOCATION: C SW/4 Section 7-29S-10W
 Kingman County, Kansas
 COMMENCED: November 10, 1976
 COMPLETED: November 22, 1976

0	976	Shale	8-5/8" casing set at 300' with
976	1520	Shale-shells	275 sacks
1520	1746	Shale	
1746	1885	Lime and shale	
1885	2215	Shale and lime	
2215	2384	Lime and shale	
2384	2670	Shale and lime	
2670	3373	Lime and shale	
3373	3400	Lime	
3400	3820	Lime and shale	
3820		T. D.	

We certify that the above and foregoing is a true and correct copy of the log of the Schnittker #1, C SW/4 Section 7-29S-10W, Kingman County, Kansas.

UNION DRILLING CO., INC.

R. D. Messinger
R. D. Messinger

STATE OF KANSAS)
) SS
 COUNTY OF SEDGWICK)

Subscribed and sworn to before me, a Notary Public in and for the aforesaid county and state as of this 29th day of November, 1976.

Donna F. Brown
Donna F. Brown, Notary Public

My commission expires: 7-29-78

DEC 29 1976